

Dickinson KANSAS

SEC. 6 TWP. 15 R. 1 E

WELL NO. # 1 N. Hall FARM

COMPANY D. T. Ingling

CONTRACTOR Co. tools


Ash Grove Pool Ft. from N. Line

330 Ft. from S. Line

330 Ft. from E. Line

Ft. from W. Line

SE SE SE

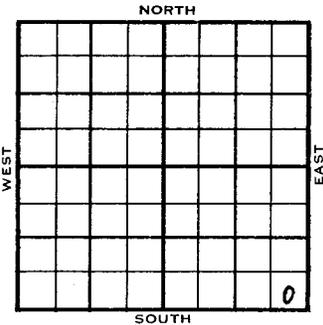

1954 ELEVATION 1322' RB - 1320 REPORT DF

9/22 Spud 9-15-54
8" @ 102'

10/20 Drlg. 1770'
Spud 9-15-54 - Oil Well

TD 2596'
8" @ 102'

Br. Lime 1910', Lans 1953', B KC 2317',
Burgess 2586', Miss 2589'

TD 2594'
4 1/2" @ 2591'

DD 2595'
Show free oil

DD 2596' 1 boph 20A, FU 1000' oil

10 hrs., 1000A
S/7 boph 3 hrs.

omp. 29 bopd

COMPLETED

DX 78-1

Dickinson KANSAS

Section 6 Township 15 Range 1 E

Well No. # 1 N. Hall

Company D. T. Ingling

