



County **Dickinson** State **Kansas**
 Sec. **6** (Blk.) **15** (Sur.) **1E** Map No.
 Operator **D. T. Ingling et al.**
 Well No. **1** Farm **Cramer**
 Elev. Location **SE NE SE**
 990 Ft. From **N** Line **SE**
 330 Ft. From **E** Line **Quarter**
 1st. Report **JAN 1 2 1955**
 Completion
 Remarks **Co. tools**
 Spudding Date **1-11-55**
 Drlg. Data **Ash Grove Pool**

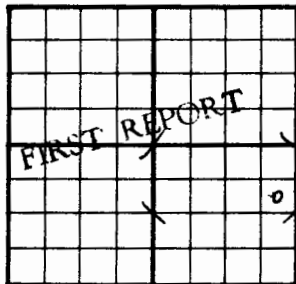

FABEN GILSTRAP

County **Dickinson** State **Kansas**
 Sec. **6** (Blk.) **15** (Sur.) **1E** Map No.
 Operator **D. T. Ingling et al.**
 Well No. **1** Farm **Cramer**
 Elev. **1313** Location **SE NE SE**
 990 Ft. From **N** Line **SE**
 330 Ft. From **E** Line **Quarter**
 1st. Report
 Completion **MAR 1 6 1955**
 Remarks **Ash Grove Pool**
 Co. tools
 Spudding Date **1-11-55**
 Drlg. Data **Oil well TD 2613**

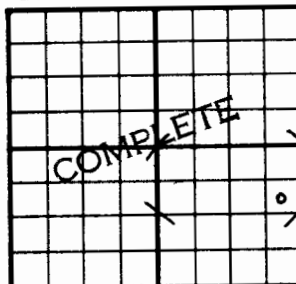

8" @ 111 Miss. 2594 TD 2601
4 1/2" @ 2597 Br. lime 1904 Lens. 1948
Burgess 2583 DD 2613 12/ 2593-96
200 A S/ 25 bo Comp. 10 bopd 4% wtr.

FABEN GILSTRAP

Dickinson

KANSAS

SEC.	TWP.	R.
6	15	1E

WELL NO.

#1 Cramer

FARM

COMPANY

D.T. Ingling et al

CONTRACTOR

Co. Tools.

Ash Grove Pool

990

Ft. from N. Line


Ft. from S. Line

330

Ft. from E. Line

Ft. from W. Line

SE NE SE

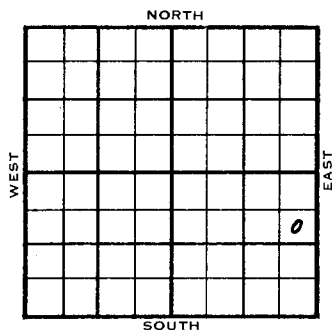

SOUTH

	ELEVATION	REPORT
1955	1313'	

1/12 Spud 1-11-55

3/16 Spud 1-11-55 Oil Well TD 2613
 8" @ 111, Miss 2594, TD 2601
 4 1/2" @ 2597 Br Lime 1904,
 Lans 1948, Burgess 2583, DD 2613
 12/2593-96 200A S/25 B0
 Comp 10 BOPD 4% Wtr.

COMPLETED

DX-78

DX 78-1


15-041-00069

Dickinson KANSAS

Section 6 Township 15 Range 1E

Well No. 1 Cramer

Company D. T. Ingling et al

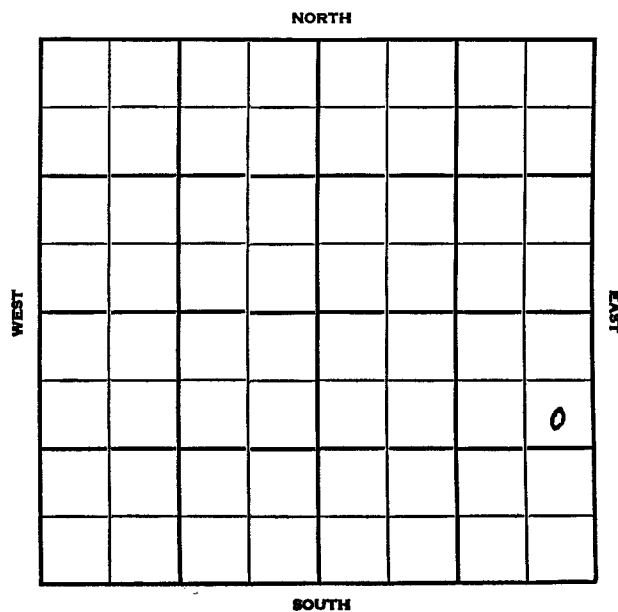

SOUTH