

Drlg. Data Ashgrove Pool

8" @ 110 w/75 Drlg 430

[illegible]

Drig. Data	Oil well	TD 2603	
8" @ 110	Lans. 1915	Burgess 2581	
Miss. 2592	TD 2600	5" @ 2598	DD 2603
1000 A	S/ 6 bfph 2 hr.	S/43 bf	50% wtr
Comp. 26 bopd	70% wtr.		

FABER LSTRAP

Dickinson

KANSAS

SEC.	TWP.	R.
7	15	1E

WELL NO.

#1 Hagg

FARM

COMPANY

D.T. Ingling

CONTRACTOR

Co. Tools.

Ashgrove Pool

NORTH

330


Ft. from N. Line

Ft. from S. Line

330

Ft. from E. Line

Ft. from W. Line

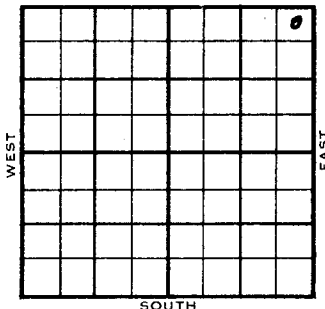

NE NE NE

1954

ELEVATION

1323'

REPORT

9/29

Spud 9-25-54
8" @ 110' w/75 sks
Drlg. 430'

11/3

Spud 9-25-54
Oil Well
TD 2603'
8" @ 110'
Lans 1915', Burgess 2581', Miss 2592
TD 2600'
5" @ 2598'
DD 2603'
1000 A S/ 6 bfph 2 hr. S/ 43 bf
50% Wtr.
Comp 26 bopd. 70% Wtr.

COMPLETED

DX 78-1


Dickinson KANSAS

Section 7 Township 15 Range 1E

Well No. 1 Hagg

Company D. T. Ingling

NORTH

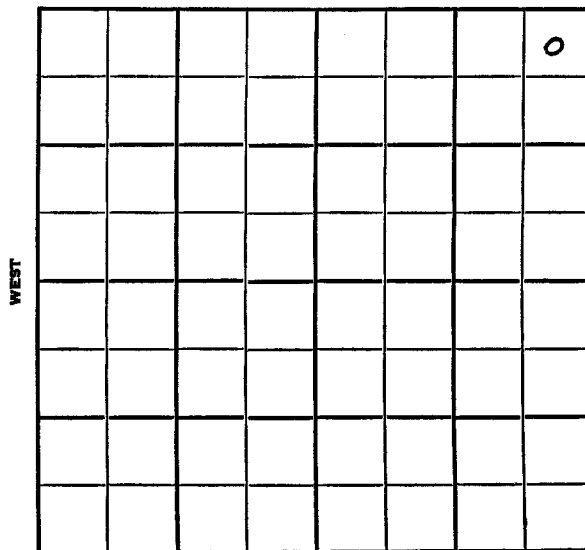

SOUTH

DX-78