

Dickinson

KANSAS

SEC.	TWP.	R.
7	15	1E

WELL NO. #1 White

COMPANY FARM E.H. Riggs et al

CONTRACTOR Prime


Ash Grove Pool

330 Ft. from N. Line

Ft. from S. Line

330 Ft. from E. Line

Ft. from W. Line

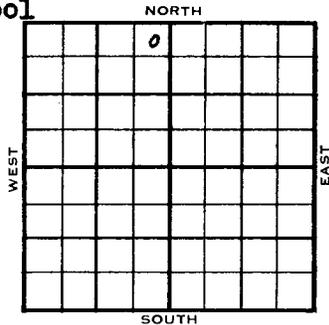

NE NE NW

	ELEVATION	REPORT
1955	1325'	
2/16	Spud 2-12-55 8" @ 108' Drlg. 880'	
2/23	Spud 2-12-55 D & A TD 2636' 8" @ 108' Br. Lime 1916' Lans 1959' Burgess 2611' DST 2611'-17' opn 1 hr, rec 375' s.w. 890# Miss. 2617' TD 2636' D & A	

ABANDONED

DX-78

DX 78-1

Dickinson

KANSAS

Section 7 Township 15 Range 1E

Well No. #1 White

Company E.H. Riggs et al

