


MAP NO. KANSAS SEC. 7 TWP. 15S R. 1EWELL NO. 1 HarrisonCOMPANY Harrison + Jones

CONTRACTOR

SECTION PLAT

ABANDONED

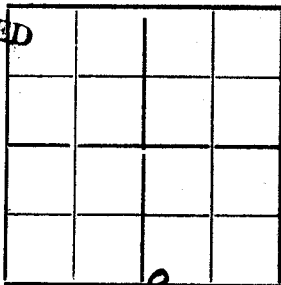

Ft. FROM N. LINE

Ft. FROM S. LINE

Ft. FROM E. LINE

Ft. FROM W. LINE

No Record

LOCATION

RIG UP

DRILLING AND REMARKS

Scout has
NEVER Reported
Nothing in
Files

RECORD

CASED IN. FT.

SAND

GAS

TOTAL DEPTH 280

PRODUCTION

1ST 24 HRS. NAT.

1ST 24 HRS. AFTER SHOT

GAS / CU. FT.

DRY HOLE /

ABANDONED

DATE

Oct 6 1920

SCOUT

Map No. KANSAS Sec. Twp. R.

Well No. Farm


Company

Ft. from N. Line

Ft. from S. Line

Ft. from E. Line

Ft. from W. Line

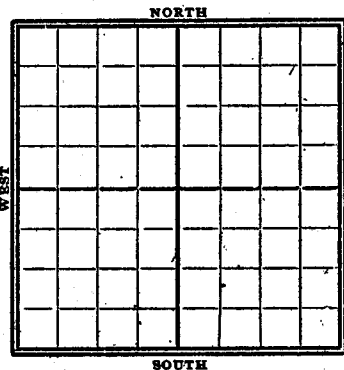

1920

Date

REPORT


10/6

Abd T.D. 2802'

Topsy Records

Form 51-5M-4-27-27423

Map No. KANSAS Sec. 7 Twp. 15^S R. 1^E
Well No. 1- Garrison Farm
Merriam & Index Company

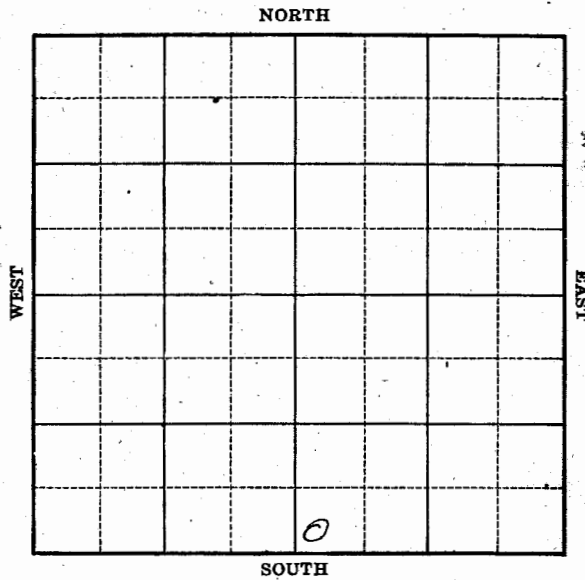

Location _____

Drilling Remarks _____

Rig Up _____

Drilling Remarks _____

RECORD

Cased _____ in. _____ ft.

Sand _____

Gas _____

Oil _____

Total Depth _____

PRODUCTION

1st 24 hrs. Nat. _____

1st 24 hrs. after shot _____

Gas _____ cu. ft.

Dry Hole _____

Abandoned _____