

County Dickinson Elev. _____
 Sec. 8 Twp. 15 Rge. 1E
 Company Don Ingling
 FarmName Strunk No. 1

TOPS	DEPTH	LOG	DATUM	Loc. in Sec.
Anh.				NW NW NE
Tr.				
H.				
Tr.				
Dg.				
Bl.				
L.				
K.C.				Geol. _____
B.K.C.				Contr. _____
Ce.				Co. tools
C.				Pool
M.				Ashgrove
Mz.				
Me.				
V.				
S.				
S.				
A.				
R.				
PE.				
G.				
TD.				

Date Comm. 6-5-55
 8" © 101/60 Drilg. 274

County Dickinson Elev. 1270
 Sec. 8 Twp. 15 Rge. 1E
 Company Don Ingling
 FarmName Strunk No. 1

TOPS	DEPTH	LOG	DATUM	Loc. in Sec.
Anh.				NW NW NE
Tr.				
H.				
Tr.				
Dg.				
Bl.				
L.	<u>1851</u>		<u>581</u>	
K.C.	<u>1897</u>		<u>627</u>	Geol. _____
B.K.C.	<u>2274</u>		<u>1004</u>	Contr. _____
Ce. <u>Burg</u>	<u>2535</u>		<u>1265</u>	Co. tools
C.				Pool
M.	<u>155</u>	<u>2539</u>	<u>1269</u>	Ashgrove
Mz.				
Me.				
V.				
S.				
S.				
A.				
R.				
PE.				
G.				
TD.				

Date Comm. 6-5-55
 8" © 101/60

D & A

Dickinson KANSAS

SEC. 8 TWP. 15 R. 1 E

WELL NO. # 1 Strunk FARM

COMPANY Don Ingling

CONTRACTOR Co. tools

Ashgrove


_____ Ft. from N. Line

_____ Ft. from S. Line

_____ Ft. from E. Line

_____ Ft. from W. Line

NW NW NE

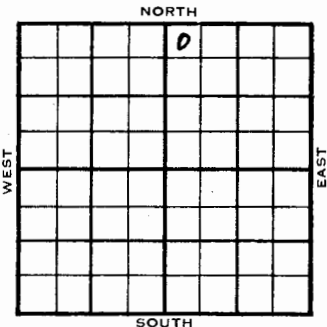

	ELEVATION	REPORT
1955	1270	

6/8 Comm. 6-5-55
8" @ 101 w/60
Drlg 274'

6/22 Comm 6-5-55
8" @ 101 /60
BL 1851, L 1897, BKC 2274, Ce Burg
2535, Miss 2539 TD 2575
D & A

ABANDONED

DX 78-1 Dickinson KANSAS

Section 8 Township 15 Range 1E

Well No. #1 Strunk

Company Don Ingling

