

Dickinson KANSAS

County **Dickinson** State **Kansas**  
 Sec. **8** (Bk. **15**) (Sur. **1E**) Map No.  
 Operator **Musgrove Pet.**  
 Well No. **1** Farm **Emig**  
 Elev. **1313** Location **NW NW SE**

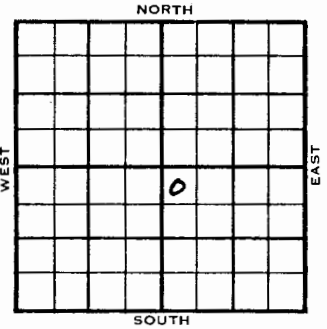

**330** Ft. From **N** Line **SE**  
**330** Ft. From **W** Line **Quarter**  
 Ist. Report **NOV 17 1954**  
 Completion **NOV 17 1954**  
 Remarks  
**Co. tools**  
 Spudding Date

Drlg. Data **D & A TD 2620 Wildcat**  
**Br. line 1914 Lans. 1964 Burgess 2578**  
**DST 2576-91 open 1 hr. Rec. 105' wtry**  
**mud 825# Miss. 2590 TD 2620**  
**D & A**

FABEN

SEC. **8** TWP. **15** R. **1E**  
 WELL NO. **#1 Emig** FARM  
 COMPANY  
 CONTRACTOR **Musgrove Pet.**

**Co. Tools.**  
**Wildcat.**  
**330** Ft. from N. Line  
 Ft. from S. Line  
 Ft. from E. Line  
**330** Ft. from W. Line  
**NW NW SE**



	ELEVATION	REPORT
1954	1313'	
11/17	D & A TD 2620' Br. Line 1914', Lans 1964', Burgess 2578', DST 2576'-91' opn 1 hr, rec 105' wtry mud, 825# Miss 2590' TD 2620' D & A	FIRST REPORT ABANDONED

Dickinson

KANSAS

DX 78-1

15-041-00025

Section 8 Township 15 Range 1E

Well No. #1 Emig

Company Musgrove Pet.

