

County Dickinson Elev. 1218				Co.
Sec. 10 Twp. 15 Rgs. 1E				
Company Don Ingling				
FarmName C. Howie No. 1				
TOPS	DEPTH	LOG	DATUM	Loc. in Sec.
Anh.				NE NE NE
TP.				
H.				
Tr.				
Dg.				
Bl.				
L.				Geol.
K.C.				Contr.
B.K.C.				Co. tools
Ce.				
C.				Pool
M.				Wildcat
Mz.				
Me.				
V.				
S.				
S.				
A.				
R.				
Pe.				
G.				
TD.				
Date Comm. 10-10-55				No.
8" @ 85/60 drlg. 2000				Sec.
				T.
				R.

County Dickinson Elev. 1218				Co.
Sec. 10 Twp. 15 Rgs. 1E				
Company Don Ingling				
FarmName C. Howie No. 1				
TOPS	DEPTH	LOG	DATUM	Loc. in Sec.
Anh.				NE NE NE
TP.				
H.				
Tr.				
Dg.				
Bl.				
L.				Geol.
K.C.				Contr.
B.K.C.				Co. tools
Ce.				
C.				Pool
M.				Wildcat
Mz.				
Me.				
V.				
S.				
S.				
A.				
R.				
Pe.				
G.				
TD.				
Date Comm. 10-10-55				No.
8" @ 85/60				Sec.
				T.
				R.

Dickinson

Dickinson KANSAS

SEC.	10	TWP.	15	R.	KANSAS 1E
------	----	------	----	----	--------------

SECTION	10	TOWNSHIP	15	RANGE	1 E
---------	----	----------	----	-------	-----

WELL NO. #1 C. Howie FARM

WELL NO. #1 C. Howie

COMPANY Don Ingling

COMPANY Don Ingling

CONTRACTOR Co. Tools
Wildcat



_____ Ft. from N. Line

_____ Ft. from S. Line

_____ Ft. from E. Line

_____ Ft. from W. Line

NE NE NE

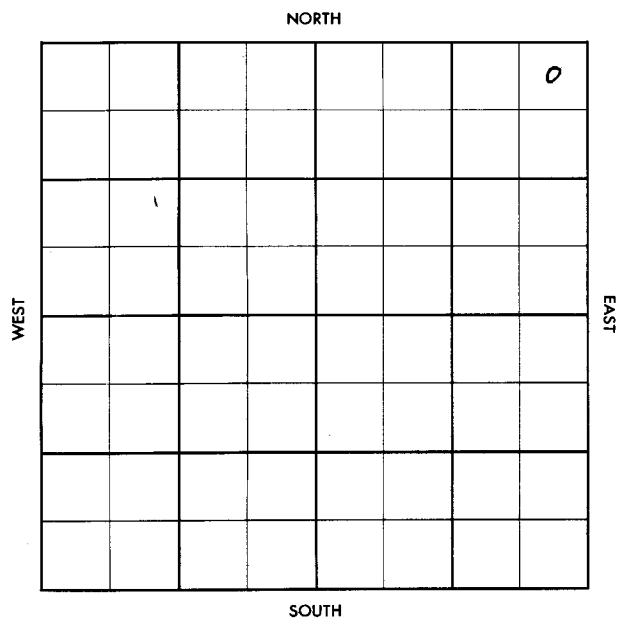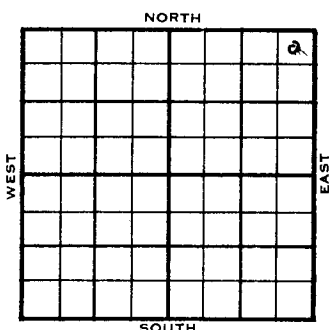

1955	ELEVATION 1218'	REPORT
------	--------------------	--------

10/19 Comm 10-10-55
8" @ 85/60
Drlg 2000

10/26 Comm 10-10-55
8" @ 85/60

Bl	1768
L	1790
Burg	2139
M	2143
TD	2166
D & A	

ABANDONED