

County **Dickinson** Elev. _____
 Sec. **11** Twp. **15** Rge. **1E**
 Company **F. W. Vishnefske**
 FarmName **E. Robson** No. **2**

TOPS	DEPTH	LOG	DATUM	Loc. in Sec.
Anh.				NE SE NW
Tr.				
H.				
Dg.				
Bl.				
L.				
K.C.				Geol. _____
B.K.C.				Contr. _____
Ce.				Ingling
M.				
K.				Pool Wildcat
Mz.				
Me.				
V.				
S.				
A.				
R.				
PE.				
G.				
TD.				

Geol. _____
 Contr. _____
 Pool **Wildcat**

FIRST REPORT
 DEC 21 '55

Date Comm. **M I R**

County **Dickinson** Elev. _____
 Sec. **11** Twp. **15** Rge. **1E**
 Company **F. W. Vishnefske**
 FarmName **E. Robson** No. **2**

No County 1214 RB
 1209 GF

TOPS	DEPTH	LOG	DATUM	Loc. in Sec.
Anh.				NE SE NW
Tr.				
H.	1632		423	
Dg.	1637		428	
Bl.	1769		500	
L.				
K.C.	1802		593	Geol. _____
B.K.C.				Contr. _____
Ce.	2409		1200	Ingling
M.	2428		1219	
K.				Pool Wildcat
Mz.				
Me.				
V.				
S.				
A.				
R.				
PE.				
G.				
TD.	2440			

Geol. _____
 Contr. _____
 Pool **Wildcat**

ABANDONED

Date Comm. **12-20-55** JAN 5 1956
8 5/8" @ 110/115
D & A

Dickinson **KANSAS**

SEC. 11 TWP. 15 R. 1E

WELL NO. #2 E. Robson FARM


COMPANY F.W. Vishnefske

CONTRACTOR Ingling

WILDCAT

_____ Ft. from N. Line
 _____ Ft. from S. Line
 _____ Ft. from E. Line
 _____ Ft. from W. Line

NE SE NW

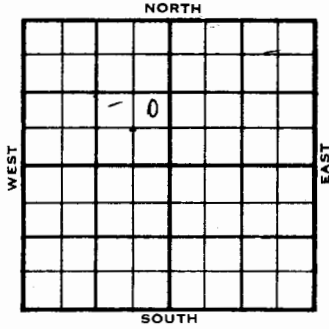

1955 ELEVATION 1214 RB, 1029 GF REPORT

12-21 MIR

1956

1-5 Comm. 12-20-55
 8 5/8" @ 110/115
 D & A
 H. 1632
 Tr. 1637
 BL. 1769
 KC. 1802
 C. 2409
 M. 2428
 TD 2440'

ABANDONED

DX-78

15-041-00105

Dickinson **KANSAS**

SECTION 11 TOWNSHIP 15 RANGE 1 E

WELL NO. #2 E. Robson

COMPANY F. W. Vishnefske

