

Form 26-1M Bk 9-23
Richardson Co
Map No. 25 Sec. 15 Twp. 15 R. 1E
Well No. 1-Phillips
Dutch Oil Company
Contractor

FIRST REPORTS

660 Ft. from N. Line
Ft. from S. Line
660 Ft. from E. Line
Ft. from W. Line

SECTION PLAT

	0		

Location
Rig up
Drilling and Remarks:

RECORD
Cased in, ft.
Sand
Gas
Oil
Total Depth

PRODUCTION

1st 24 hrs. Nat.
1st 24 hrs. after shot
Gas Cu. Ft.
Dry Hole
Abandoned

Date
3-7-34 192 O. Mammuch

Form 26-1M Bk 9-23
Richardson
Map No. 25 Sec. 15 Twp. 15 R. 1E
Well No. 1-Phillips
Dutch Oil Company
Contractor

SECTION PLAT

660 Ft. from N. Line
Ft. from S. Line
660 Ft. from E. Line
Ft. from W. Line

	0		

Location
Rig up
Drilling and Remarks:

RECORD
Cased in, ft.
Sand
Gas
Oil
Total Depth 3544

PRODUCTION

1st 24 hrs. Nat.
1st 24 hrs. after shot
Gas Cu. Ft.
Dry Hole
Abandoned

Date
2-19-36 192 Scout

Fr. 5K. 4 JPC

Dickinson

Map No. KANSAS Sec. 15 Twp. 15 R. 1E

Well No. 1 Phillips Farm

Dutch Oil


Company

660 Ft. from N. Line

Ft. from S. Line

660 Ft. from E. Line

Ft. from W. Line

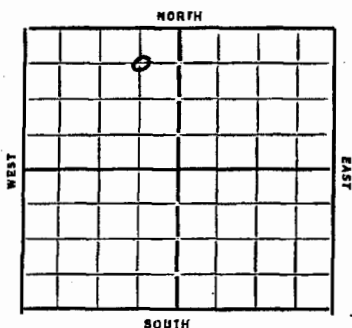

Date	REPORT
1934	
3/7	Spud
3/15	
3/22	Dly 100
3/29	" 120
4/5	SD 250
4/12	
4/19	15" 302
4/26	SD 715
5/3	Run 12" 935
5/10	Dly 1255
5/18	5/25
5/31	SD 1565
6/7	
6/14	UR 10" 1650
6/21	Dly 1770
6/28	SD 1770
7/5	
7/12	Dly 2025
7/19	7/26 — 8/2
8/9	H 7 2000' 8" 2000
	SD 2300
8/16	2300 U.C. 8" — OVER

8/23 Dly 2325

8/30 " 2450

9/6 — 9/13 — 9/20 — 9/27 —

10/4 Dly 2475 8" 2300

10/11 2475 U.C.

10/18 —

10/25 8" 2500 51

11/1 — 11/8 — 11/15 —

11/22 C.O. 2500

11/28 —

12/6 Top line 2487 Dly 2495

12/13 U.C. 8"

12/21 —

12/27 Dly 2497

1/3/35 " 2511

1/10 " 2615

1/17 " 2655

1/24 — 1/31 — 2/7 —

2/14 SD 2703

2/21 —

2/28 Dly 2714

3/7 — 3/14 — 3/21 — 3/28 —

4/4 — 4/11 — 4/18 — 4/26 —

5/2 — 5/9 — 5/16 — 5/23 —

5/29 — 6/6 —

6/13 6" 2714 2708 U.C. 6"

6/20 Hinton 2808 HFW 2812
57 2880

6/28 — 7/3 — 7/11 — 7/18 —
8/8 — 8/15 — 8/22 —

8/29 dly 3148 5" 3090

9/6 SD 3282

10/3 — 10/10 — 11/1 — 11/7 —

11/14 dly 3430

11/21 " 3515

11/29 SD 3535

12/6 — 12/13 — 12/19 — 12/26 — 1/2/36 —

1/10 — 1/17 — 1/24 — 1/31 — 2/7 —

2/14 —

2/19 TD 3544

D. & F.

ABANDONED

15-041-00159

Dickinson

Form 51-5M-11-31-Palace

Map No. KANSAS

Sec. 15

Twp. 15

R. 1

E


Well No. 1

Phillips

Farm

Dutch Oil

Company

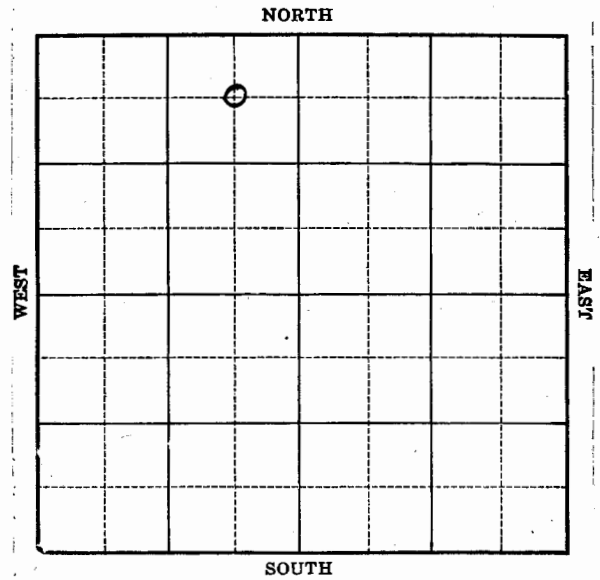

Location

Drilling Remarks

Rig Up

Drilling Remarks

RECORD

Cased in. ft.

Sand

Gas

Oil

Total Depth

PRODUCTION

1st 24 hrs. Nat.

1st 24 hrs. after shot

Gas cu. ft.

Dry Hole

Abandoned