

County **Dickinson** State **Kansas**
 Sec. **33** (Blk. **15S** (Sur. **1R** Map No.
 Operator **Ingling Drlg**
 Well No. **1** Farm **Bogart**
 Elev. Location **SE SE SW**

330 Ft. From **S** Line
330 Ft. From **E** Line **SW** Quarter
 1st. Report **DEC 8 1954**
 Completion
 Remarks **Co. tools**
 Spudding Date **12-6-54**
 Drlg. Data **Wildcat**
8" @ 102 . WOC

FABEN GILSTRAP

County **Dickinson** State **Kan.**
 Sec. **33** (Blk. **15** (Sur. **1E** Map No.
 Operator **Ingling Drlg.**
 Well No. **1** Farm **Bogart**
 Elev. **1340** Location **SE SE SW**

330 Ft. From **S** Line **SW**
330 Ft. From **E** Line **Quarter**
 1st. Report
 Completion **DEC 22 1954**
 Remarks **Wildcat**
Co. tools
 Spudding Date **12-6-54**
 Drlg. Data **D & A TD 2657**
8" @ 102 Br. lime 1985 KC 1987
Burgess 2625 Miss. 2628 Miss. chat 2654
DST 2630-57 open 15 min. Rec. 420' msw
790# TD 2657

D & A

FABEN GILSTRAP

Dickinson KANSAS

SEC. 33 TWP. 15S R. 1E
WELL NO. 1 Bogart FARM

COMPANY Ingling Drlg.

CONTRACTOR Co. Tools
Wildcat


Ft. from N. Line

330 Ft. from S. Line

330 Ft. from E. Line

Ft. from W. Line

SE SE SW

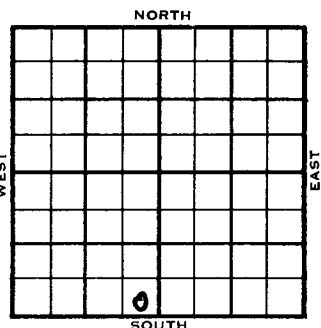

1954 ELEVATION 1340' REPORT

12/8 Spud 12-6-54
8" @ 102', WOC

12/22 Spud 12-6-54
D & A
TD 2657'
8" @ 102'
Br. Lime 1985' KC 1987' Burgess 2625'
Miss 2628' Miss C-at. 2654'
DST 2630'-57' opn 15 min, rec 420' msw.
790#
TD 2657'
D & A

ABANDONED

DX-78

DX 78-1 15-041-00023 Dickinson KANSAS

Section 33 Township 15 Range 1 E

Well No. # 1 Bogart

Company Ingling Drlg.

