

WELL COMPLETION REPORT AND
DRILLER'S LOG

API No. 15 — 041 — 20050
County _____ Number _____

Operator

B M & S Oil Company

Address

Well No.

Lease Name

2 White

Footage Location 4319 FSL and 3970 FEL -KCC Record

990 feet from (N) line 1320 feet from (W) (W) line

Principal Contractor Geologist
Ks. Drilg. & Well Serv., Inc. H. C. Hopkins

Spud Date

Date Completed

Total Depth

P.B.T.D.

3-16-81

3-19-81

2682'

Directional Deviation

Oil and/or Gas Purchaser

S. 7 T. 15 R. 1E E
W


Loc. S/2-N/2-NW SE NW NW -

KCC Record

County Dickinson

640 Acres

N

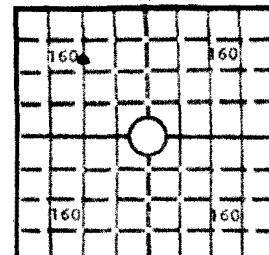

Locate well correctly

Elev.: Gr. 1328

DF _____ KB _____

CASING RECORD

Report of oil strings set — surface, intermediate, production, etc.

Purpose of string	Size hole drilled	Size casing set (in O.D.)	Weight lbs/ft.	Setting depth	Type cement	Sacks	Type and percent additives
Surface		8 5/8"		125'	Class A Common	125	2% CACL
Production		4 1/2"		2682' KB	60-40 Pozmix	75	

LINER RECORD

PERFORATION RECORD

Top, ft.	Bottom, ft.	Sacks cement	Shots per ft.	Size & type	Depth interval

TUBING RECORD

Size	Setting depth	Packer set at			
2" EUE	2535'		1 1/2	15Gr-VJ	2640-46'

ACID, FRACTURE, SHOT, CEMENT SQUEEZE RECORD

Amount and kind of material used

RECEIVED Depth Interval treated

STATE CORPORATION COMMISSION

None

MAY 19 1981

CONSERVATION DIVISION
Wichita, Kansas

INITIAL PRODUCTION

Date of first production 4/11/81 Producing method (flowing, pumping, gas lift, etc.) Pumping

RATE OF PRODUCTION PER 24 HOURS	Oil 15 bbls.	Gas MCF	Water 100 bbls.	Gas-oil ratio CFPB

Disposition of gas (vented, used on lease or sold) Producing interval(s)


INSTRUCTIONS: As provided in KCC Rule 82-2-125, within 90 days after completion of a well, one completed copy of this Drillers Log shall be transmitted to the State Geological Survey of Kansas, 4150 Monroe Street, Wichita, Kansas 67209. Copies of this form are available from the Conservation Division, State Corporation Commission, 245 No. Water, Wichita, Kansas 67202. Phone AC 316-522-2206. If confidential custody is desired, please note Rule 82-2-125. Drillers Logs will be on open file in the Oil and Gas Division, State Geological Survey of Kansas, Lawrence, Kansas 66044.

operator

B. M. & S. Oil

DESIGNATE TYPE OF COMP.: OIL, GAS,
DRY HOLE, SWDW, ETC.

Oil

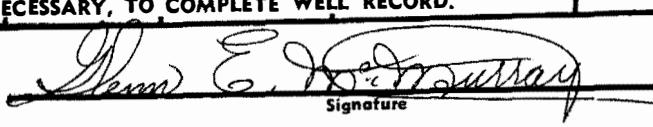Well No. 2	Lease Name W hite	Oil		
S 7 T 15 R 1 E XX				
WELL LOG Show all important zones of porosity and contents thereof; cored intervals, and all drill-stem tests, including depth interval tested, cushion used, time tool open, flowing and shut-in pressures, and recoveries.				SHOW GEOLOGICAL MARKERS, LOGS RUN, OR OTHER DESCRIPTIVE INFORMATION.
FORMATION DESCRIPTION, CONTENTS, ETC.	TOP	BOTTOM	NAME	DEPTH
0-2140 lime & shale				
2140-2310 Lans.				
2310-2647 K.C.				
2647-2682 Miss				
2682 TD				
USE ADDITIONAL SHEETS, IF NECESSARY, TO COMPLETE WELL RECORD.				
Date Received	 Signature			
	 Partner			
	Title			
	5/16/81 Date			