

Waubaunsee **KANSAS**Sec. 2 Twp. 15 R. 10EWell No. #2 Buchli Farm

Carter Oil Company

Woodbury Pool Contractor


Ft. from N. Line

330 Ft. from S. Line

330 Ft. from E. Line

Ft. from W. Line

SE SE SE

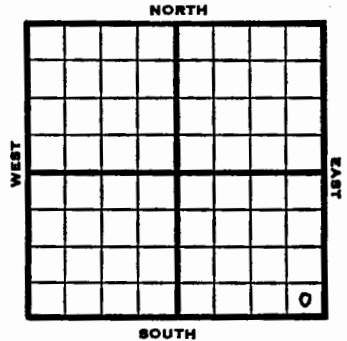County Waubaunsee State Kansas
Sec. 2 (Blk. Twp.) 15 (Sur. Rge.) 10E Map No.Operator Carter OilWell No. 2 Farm BuchliElev. Location SE SE SE330 Ft. From S Line SE330 Ft. From R Line Quarter1st. Report DEC 3 1952

Completion

Remarks

Spudding Date

Drlg. Data Woodbury Pool

Location

1952 Elev. - REPORT

12/3 Location

1953

1/7


Spud 12-10-52 D & A TD 3191'
 8" @ 190 Lans. 1503' KC 1660'
 B KC 1868' Miss. 2522' Kh. 2882'
 Hunton 3028' Maq. 3113' Viola 3186'
 TD 3191' DST 3187-91 open 2 hr.
 rec 157' oil, 562' wtr. 1105#
 D & A

ABANDONED

3028
 2522
 506

J. G. McGEHEE

County Waubaunsee State Kansas
 Sec. 2 (Bk.) 15 (Sur.) 10E Map No.
 Operator Carter Oil
 Well No. 2 Farm Buchli
 Elev. Location SE SE SE

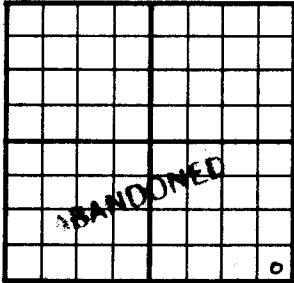

330 Ft. From S Line SE
330 Ft. From E Line Quarter

1st. Report

Completion JAN 7 1953

Remarks Woodbury Pool

Spudding Date 12-10-52

Drlg. Data D & A TD 3191

8" C 190 Lans. 1503 KC 1660 B KC 1868

Miss. 2522 Kh. 2882 Hunton 3028

Maq. 3113 Viola 3186 TD 3191

DST 3187-91 open 2 hr. Rec. 157' oil

562' wtr. 1105#

D & A

J. G. McGEHEE

Section 2 Township 15 Range 10 E

Well No. # 2 Buchli

Company Carter Oil

