

Waubaunsee

KANSAS

Sec. 2 Twp. 15 R. 10E

Well No. #1 Buchli Farm _____

Carter Oil Company _____

Woodbury Pool Contractor _____


_____ Ft. from N. Line

330 Ft. from S. Line

_____ Ft. from E. Line

990 Ft. from W. Line

SE SW SE

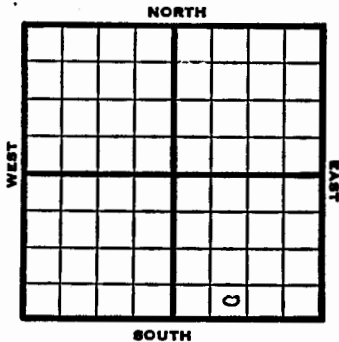


Waubaunsee

KANSAS

Section 2 Township 15 Range 10E

Well No. #1 Buchli

Company Carter Oil

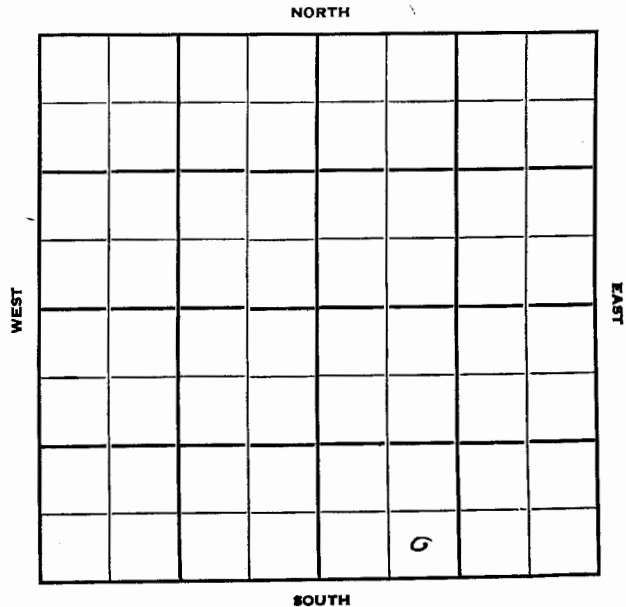

1952 Elev. 1436' REPORT

10/8 Location

11/26 Spud 10-11-52
 Oil well TD 3222' 8" @ 192
 Heeb 1261' Lans. 1544' KC 1707
 B KC 1916 Miss 2561 Kh. 2916
 Hunton 3064 Viola 3214
 DST 3218-22 open 2 hr. rec 1400' oil
 570# TD 3222' 5" @ 3214 CO to
 3218' FU 700' oil
 Comp. 122 BOPD

COMPLETED