

name *o. Lacy Co*
 Map No. **KANSAS** Sec. *19* Twp. *15* R. *16*
 Well No. *1 unknown*
Howard at #*6* Company
 Contractor

SECTION PLAT

Ft. from N. Line

200 Ft. from S. Line*200* Ft. from E. Line

Ft. from W. Line

FIRST REPORTS

Location ☒

Rig up

Drilling and Remarks:

RECORD

Cased _____ in., _____ ft.

Sand _____

Gas _____

Oil _____

Total Depth _____

PRODUCTION

1st 24 hrs. Nat. _____

1st 24 hrs. after shot _____

Gas _____ Cu. Ft.

Dry Hole _____

Abandoned _____

Date

MAR 3 1926

CHAS. L. SHERWOOD

192

Scout

name *Franklin Co*
 Map No. **KANSAS** Sec. *19* Twp. *15* R. *18 E*
 Well No. *1 unknown*
Howard at #*6* Company
 Contractor

SECTION PLAT

Ft. from N. Line

200 Ft. from S. Line*200* Ft. from E. Line

Ft. from W. Line

CORRECTION

Location ☒

Rig up

Drilling and Remarks:

*Chg Range #**and County to**above. Also Report**to Range 16 E*

RECORD

Cased _____ in., _____ ft.

Sand _____

Gas _____

Oil _____

Total Depth _____

PRODUCTION

1st 24 hrs. Nat. _____

1st 24 hrs. after shot _____

Gas _____ Cu. Ft.

Dry Hole _____

Abandoned _____

Date

MAR 18 1926


CHAS. L. SHERWOOD

192

Scout

Map No. Kansas Sec. 19 Twp. 15 R. 18
 Well No. 1 Unknown Farm
Howard et al Company

NORTH

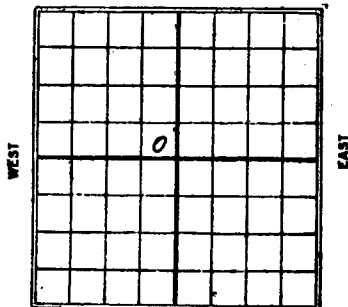

Ft. from N. Line

200' Ft. from S. Line200' Ft. from E. Line

Ft. from W. Line

1926

Date REPORT

3/3	Location
3/10	
3/18	Same Change Range
	no from 16-18.
3/25	
3/31	
4/7	
4/14	
4/21	
4/28	
5/8	Same
5/14	Dlg 1438'
5/19	
6/2	same
6/10	
6/18	
6/25	
6/30	
7/9	
7/15	
7/21	D + A 1534 - T.D.

Map No. KANSAS Sec. 19 Twp. 15 R. 18
 Well No. 1 Unknown
Howard et al Company

Contractor


COMPLETED

SECTION PLAT

Ft. from N. Line

200 Ft. from S. Line200 Ft. from E. Line

Ft. from W. Line

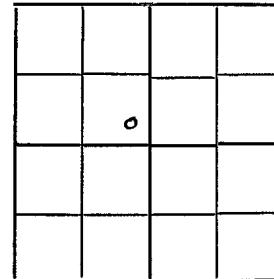

ABANDONED

Location

Rig up

Drilling and Remarks:

Dlg
1534

RECORD

Cased.....in.,ft.

Sand

Gas

Oil.....

Total Depth 1534

PRODUCTION

1st 24 hrs. Nat.

1st 24 hrs. after shot.....

Gas.....Cu. Ft.

Dry Hole ☒Abandoned ☒

Date

JUL 21 1926


CHAS. L. SHERWOOD

192 Scout

15-059-00006

Map No. HansonsSec. 19Twp. 15R. 18EWell No. 1UnknownDaniel
Barnhardt

Company

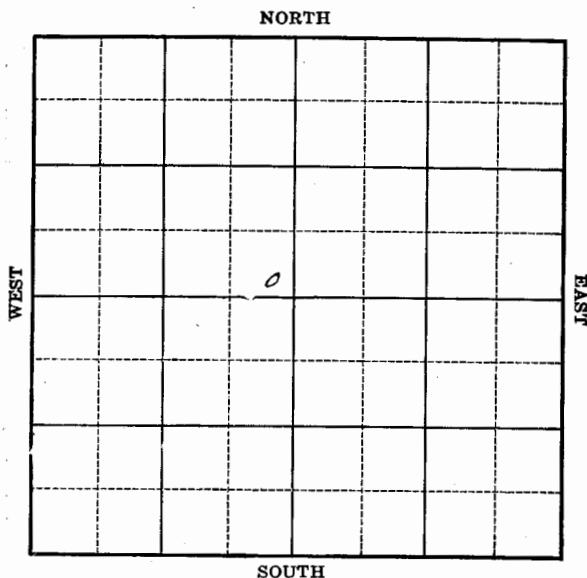

Location _____

Drilling Remarks _____

RECORD

Cased _____ in. _____ ft.

Sand _____

Gas _____

Oil _____

Total Depth _____

Rig Up _____

Drilling Remarks _____

PRODUCTION

1st 24 hrs. Nat. _____

1st 24 hrs. after shot _____

Gas _____ cu. ft.

Dry Hole _____

Abandoned _____