

Map No. 25 Sec. 1 Twp. 15 R. 2EWell No. 1 L. Meuli

Transwestern Company
FIRST REPORT Contractor

SW/C

SECTION PLAT

Ft. from N. Line


330

Ft. from S. Line

Ft. from E. Line

330

Ft. from W. Line

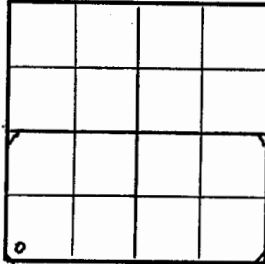

Wildcat

Location

Rig up

Drilling and Remarks:

Cable

RECORD

Cased in, ft.

Sand

Gas

Oil

Total Depth

PRODUCTION

1st 24 hrs. Nat.

1st 24 hrs. after shot

Gas Cu. Ft.

Dry Hole

Abandoned

Date

DEC 1 1943 19 S. J. LEWIS Scout

Map No. 25 Sec. 1 Twp. 15 R. 2EWell No. 1 L. Meuli

Transwestern Company
ABANDONED Contractor

SW/C

SECTION PLAT

Ft. from N. Line


330

Ft. from S. Line

Ft. from E. Line

330

Ft. from W. Line

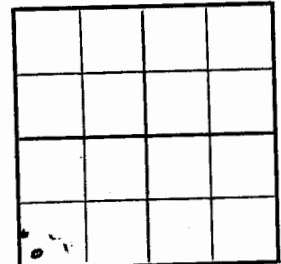

Wildcat

Location

Rig up

Drilling and Remarks:

Wire 2326

RECORD

Cased in, ft.

Sand

Gas

Oil

Total Depth 2426

PRODUCTION

1st 24 hrs. Nat.

1st 24 hrs. after shot

Gas Cu. Ft.

Dry Hole

Abandoned

Date

FEB 9 1944 19 S. J. LEWIS Scout


KANSAS

Dickinson

Sec. 1 Twp. 15 R. 2-E

Well No. #1 L. Mauli Farm

Transwestern Company

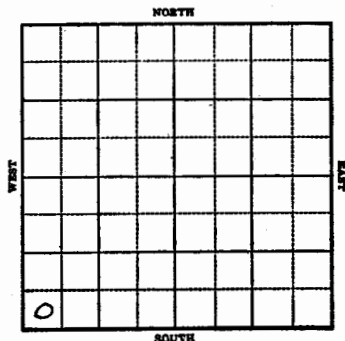

Ft. from N. Line

330 Ft. from S. Line

Ft. from E. Line

330 Ft. from W. Line

1943 Elev. 1231 REPORT

12/1 Cable
12/8 "
12-15 15" at 150
Drlg 360'
12/22 Crooked hole to plug back
12/29 15" @ 154 Drlg 400'
1944
1-5 Drlg 1045'
1-12 Drlg 1400'
1/19 Drlg. 1800'
1/26 Drlg. 2096'
2/2 12" @ 1265
KC 1725
10" @ 1723
Miss 2326
8" @ 2330
800' water @ 2360
Drlg. 2380
2/9 Miss 2326
TD 2476'

ABANDONED

Dickinson

15-041-00124

Section 1 Township 15 Range 2E

Well No. #1 L. Mauli

Company Transwestern

