KANSAS

15-045-20224

2886 FSL and 57 FEL
SE SE NE-KCC Record

WELL COMPLETION REPORT AND DRILLER'S LOG

State Geological Survey
WICHITA BRANCH


S. 11 T. 15 R. 20 (E) W

API No. 15 — 045 — 20,224
County Number

Loc. NE ¼

County Douglas

640 Acres
N

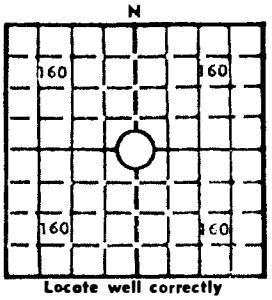

Locate well correctly

Elev.: Gr.

DF KB

Operator
Kent Fry

Address
P. O. Box 3747, Lawrence, KS 66044

Well No.	Lease Name
2-81	Wright

Footage Location
280 feet from (N) (S) line 50 feet from (E) (W) line

Principal Contractor	Geologist		
C & R Drilling, Inc.			
Spud Date	**Date Completed**	**Total Depth**	**P.B.T.D.**
6/18/81	6/19/81	912	
Directional Deviation	**Oil and/or Gas Purchaser**		
	Maclaskey		

CASING RECORD

Report of all strings set — surface, intermediate, production, etc.

Purpose of string	Size hole drilled	Size casing set (in O.D.)	Weight lbs/ft.	Setting depth	Type cement	Sacks	Type and percent additives
Surface	9¼	6¼		100	Portland	120	
Production	5¼	2 3/8	2.75	909			

LINER RECORD

Top, ft.	Bottom, ft.	Sacks cement

TUBING RECORD

Size	Setting depth	Packer set at

PERFORATION RECORD

Shots per ft.	Size & type	Depth interval
2	1 11/16 glass jets	862-874

ACID, FRACTURE, SHOT, CEMENT SQUEEZE RECORD

Amount and kind of material used	Depth interval treated
Fractured with 50 sacks of sand & 110 bbls of water	862-874

INITIAL PRODUCTION

Date of first production	Producing method (flowing, pumping, gas lift, etc.)
7/14/81	Pumping

RATE OF PRODUCTION PER 24 HOURS	Oil	Gas	Water	Gas-oil ratio
	4 bbls.	MCF	1 bbls.	CFPB

Disposition of gas (vented, used on lease or sold)	Producing interval(s)
	862-874

INSTRUCTIONS: As provided in KCC Rule 82-2-125, within 90 days after completion of a well, one completed copy of this Drillers Log shall be transmitted to the State Geological Survey of Kansas, 4150 Monroe Street, Wichita, Kansas 67209. Copies of this form are available from the Conservation Division, State Corporation Commission, 245 No. Water, Wichita, Kansas 67202. Phone AC 316-522-2206. If confidential custody is desired, please note Rule 82-2-125. Drillers Logs will be on open file in the Oil and Gas Division, State Geological Survey of Kansas, Lawrence, Kansas 66044.

C-10-1972

WELL RECORD

11-15-20E

Well No. 2-81 Farm Wright Producer Advanco

Location 50'FEL 280'FNL Sec. 11 Twp. 15 Rg. 20E

Elevation State Kansas County Douglas

Kind (Oil, Gas, Water, Dry Hole) Oil Contractor C & R Drilling

Producing formation Squirrel Top Bottom

Shot with qts. from to

Packer Set at Kind Size

Liner from to Perforated from to

LOG

Thickness	Strata	Depth	Thickness	Strata	Depth
10	Soil & Clay	10	172	Shale	759
2	Sand	72	8	Lime	767
7	Lime & Sand	79	7	Shale	774
137	Shale	216	4	Lime	778
5	Lime	221	6	Shale	784
6	Shale	227	8	Lime	792
14	Lime	241	14	Shale	806
8	Shale	249	3	Lime	809
8	Lime	257	14	Shale	823
6	Shale	263	10	Lime	833
17	Lime	280	29	Shale	862
32	Shale	312	18	Sand-Oil	880
20	Lime	332	32	Shale	912
75	Shale	407			
	Lime	430		TD 912'	
19	Shale	449		SN 859'	
4	Lime	453			
25	Shale	478			
	Lime	493			
20	Shale	513			
25	Lime	538			
7	Shale	545			
23	Lime	568			
3	Shale	571			
5	Lime	576			
4	Shale	580			
7	Lime	587			

Total Depth 912'

Open Hole

Casing Surface 100' at

Casing at

Casing at

Cement

Tubing 2" 909'

Rods

Additional Information

1-Float Shoe

1-Seating Nipple

3-Centralizers

Core:

862-864 Broken Sand

864-866 Shale

866-867 Broken Sand

867-875 Solid Sand

875-880 Broken Sand

Date Completed O. K.

Superintendent