

4-15-20E

Log Book

Well No. 1


Farm Jac Brewer
Man Franklin
(State) (County)

4 15 20E
(Section) (Township) (Range)

For Jac Brewer
PLUGGING
FILE SEC 4 T 15 R 20E
BOOK PAGE 51 LINE 19

F. W. BLACK
Oil & Gas Well Supplies
OSAWATOMIE PAOLA
Phone 544 APR 22 1946 Phone 210

Brewer Farm; Franklin County
Man State; Well No. 1
Elevation
Commenced Spudding 4-3, 1944
Finished Drilling 4-17, 1944
Driller's Name
Driller's Name
Driller's Name
Tool Dresser's Name
Tool Dresser's Name
Tool Dresser's Name
Contractor's Name
4 15 20E
(Section) (Township) (Range)
Distance from line, ft.
Distance from line, ft.

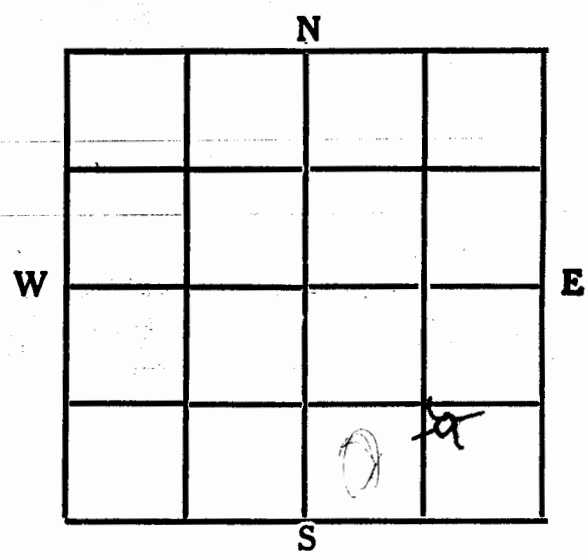

4-15-20E

Thickness of Strata	Formation	Total Depth	Remarks
18	Surface	18	Set 37 ft ^{8 in} 37 ft of 8 in pipe
12	Sand rock	30	
128	Shale	158	
7	Lime	165	
2	Shale	167	
10	Lime	177	
10	Shale	187	
11	Lime	198	
2	Shale	200	
25	Lime	225	
2	Shale	227	
6	Lime	233	
7	Shale	240	
16	Lime	256	
4	Shale	260	Water
12	Sand	272	
73	Shale	345	
12	Lime	357	
4	Shale	361	
3	Lime	364	
10	Shale	374	
8	Lime	382	
18	Shale	400	
2	Lime	402	
10	Shale	412	
9	Lime	421	
22	Shale	443	

4-15-20E

Thickness of Strata	Formation	Total Depth
		443
22	Lime	465
9	Shale	474
22	Lime	496
3	Shale	499
9	Lime	508
2	Shale	510
10	Lime	520
173	Shale	693
5	Lime	698
14	Shale	712
2	Lime	714
11	Shale	725
10	Lime	735
4	Sandy Shale	739
14	Lime	753
19	Shale	772
2	Lime	774
5	Shale	779
10	Sand	789
33	Shale	822

KCC

MAR 20 1991

Water 714-725

Set 758 ft $\frac{1}{4}$ casing

Little Water Sills Gas
779-789

Bottom Hole
822 ft