

WELL COMPLETION REPORT AND
DRILLER'S LOG

WICHITA

S. 12 T. 15 R. 20 ^(E)_(W)

API No. 15 — 045 — 20,238
County Number

Loc. SW $\frac{1}{4}$
County Douglas

Operator
Kent Fry

Address
P. O. Box 3747, Lawrence, KS 66044


Well No. 2-81 Lease Name Jones, KCC record

Footage Location 810 1683 FSL ; 47⁵⁶ FEL
feet from (N) (S) line feet from (E) (W) line of SW $\frac{1}{4}$

Principal Contractor C & R Drilling, Inc. Geologist

Spud Date 7/9/81 Date Completed 7/10/81 Total Depth 896 P.B.T.D.

Directional Deviation Oil and/or Gas Purchaser Maclasley

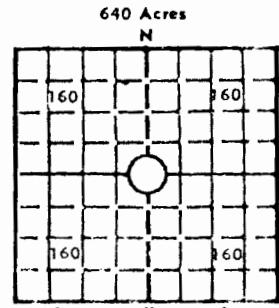

Elev.: Gr. _____
DF _____ KB _____

CASING RECORD

Report of all strings set — surface, intermediate, production, etc.

Purpose of string	Size hole drilled	Size casing set (in O.D.)	Weight lbs/ft.	Setting depth	Type cement	Sacks	Type and percent additives
Surface	9 $\frac{1}{4}$	6 $\frac{1}{4}$		80	Portland	118	
Production	5 $\frac{1}{4}$	2 3/8	2.75	896			

LINER RECORD

PERFORATION RECORD

Top, ft.	Bottom, ft.	Sacks cement	Shots per ft.	Size & type	Depth interval
			2	1 11/16 glass jets	850-862

TUBING RECORD

Size	Setting depth	Packer set at

ACID, FRACTURE, SHOT, CEMENT SQUEEZE RECORD

Amount and kind of material used	Depth interval treated
Fractured with 50 sacks of sand and 110 bbls of water	850-862

INITIAL PRODUCTION

Date of first production 7/14/81		Producing method (flowing, pumping, gas lift, etc.) Pumping			
RATE OF PRODUCTION PER 24 HOURS	Oil 3 bbls.	Gas MCF	Water 3 bbls.	Gas-oil ratio	CFPB
Disposition of gas (vented, used on lease or sold)			Producing interval (s) 850-862		

INSTRUCTIONS: As provided in KCC Rule 82-2-125, within 90 days after completion of a well, one completed copy of this Drillers Log shall be transmitted to the State Geological Survey of Kansas, 4150 Monroe Street, Wichita, Kansas 67209. Copies of this form are available from the Conservation Division, State Corporation Commission, 245 No. Water, Wichita, Kansas 67202. Phone AC 316-522-2206. If confidential custody is desired, please note Rule 82-2-125. Drillers Logs will be on open file in the Oil and Gas Division, State Geological Survey of Kansas, Lawrence, Kansas 66044.

WELL RECORD

12-15-20E

Well No. 2 31 Farm Jones Producer Advanco, Inc.
 Location _____ Sec. 12 Twp. 15 Rg. 20E
 Elevation _____ State Kansas County Douglas
 Kind (Oil, Gas, Water, Dry Hole) Oil Contractor C & R Drilling
 Producing formation Squirrel Top _____ Bottom _____
 Shot with _____ qts. _____ from _____ to _____
 Packer Set at _____ Kind _____ Size _____
 Liner _____ from _____ to _____ Perforated from _____ to _____

LOG

Thick-ness	Strata	Depth	Thick-ness	Strata	Depth
5	Soil & Clay	5	175	Shale	743
74	Sand	79	5	Lime	748
4	Lime	83	7	Shale	755
8	Shale	91	3	Lime	758
3	Lime	94	9	Shale	767
102	Shale	196	9	Lime	776
8	Lime	204	12	Shale	788
6	Shale	210	4	Lime	792
13	Lime	223	17	Shale	809
7	Shale	230	6	Lime	815
9	Lime	239	24	Shale	839
6	Shale	245	7	Lime	846
18	Lime	263	13	Oil sand	859
35	Shale	298	37	Shale	896
17	Lime	315			
73	Shale	388		TD 896'	
23	Lime	411		SN 843'	
17	Shale	428			
8	Lime	436			
22	Shale	458			
18	Lime	476			
20	Shale	496			
24	Lime	520			
8	Shale	528			
32	Lime	550			
5	Shale	555			
4	Lime	559			
4	Shale	563			
5	Lime	568			

Total Depth 896'

Open Hole

Surface Casing 80' at _____
 Casing _____ at _____
 Casing _____ at _____
 Cement _____
 2" Tubing 896'

Rods

Additional Information

_____ 1-Clamp
 _____ 1-Seating Nipple
 _____ 1-Float Shoe
 _____ 3-Centralizers

Date Completed _____

O. K.

Superintendent