

WICHITA BRANCH
KANSAS DRILLERS LOG

S. 13 T. 15 R. 20 ^E/_W

Loc. W $\frac{1}{2}$ -SW $\frac{1}{4}$

County Douglas

API No. 15 — 045 — 20095 ✓
County Number

Operator
Reese Exploration, Inc.

Address
PO Box 11598, KCMO 64138


Well No. 2-79 Lease Name Mad1

Footage Location 1691 FSL; 5147 FEL - KCC record
920 feet from (N) ~~XS~~ line 40 feet from (E) (W) line

Principal Contractor Michael Drilling Geologist

Spud Date August, 1979 Total Depth 870' P.B.T.D.

Date Completed Nov. Oil Purchaser Bluebird Oil Co.

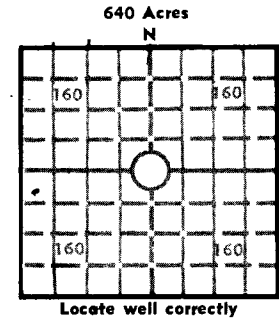

Elev.: Gr. _____

DF _____ KB _____

CASING RECORD

Report of all strings set — surface, intermediate, production, etc.

Purpose of string	Size hole drilled	Size casing set (in O.D.)	Weight lbs/ft.	Setting depth	Type cement	Sacks	Type and percent additives
Surface	8-7/8	6-1/4	17#	40	Portland	4	none
2"	5-1/4	2-3/8	4#	856	"	90	2% Gel

LINER RECORD

PERFORATION RECORD

Top, ft.	Bottom, ft.	Sacks cement	Shots per ft.	Size & type	Depth interval
none					

Size	Setting depth	Packer set at
none		

ACID, FRACTURE, SHOT, CEMENT SQUEEZE RECORD

Amount and kind of material used	Depth interval treated
Frac Hot Oil - 100 sacks sand	

INITIAL PRODUCTION

Date of first production <u>Dec. 1979</u>	Producing method (flowing, pumping, gas lift, etc.) <u>Pumping</u>
RATE OF PRODUCTION PER 24 HOURS	Oil <u>1</u> bbls. Gas <u>0</u> MCF Water _____ Gas-oil ratio _____ CFPB
Disposition of gas (vented, used on lease or sold)	Producing interval (s)

INSTRUCTIONS: As provided in KCC Rule 82-2-125, within 90 days after completion of a well, one completed copy of this Drillers Log shall be transmitted to the State Geological Survey of Kansas, 4150 Monroe Street, Wichita, Kansas 67209. Copies of this form are available from the Conservation Division, State Corporation Commission, 3830 So. Meridian (P.O. Box 17027), Wichita, Kansas 66217. Phone AC 316-522-2206. If confidential custody is desired, please note Rule 82-2-125. Drillers Logs will be on open file in the Oil and Gas Division, State Geological Survey of Kansas, Lawrence, Kansas 66044.

14-16-21E

Operator
Reese Exploration, Inc.

DESIGNATE TYPE OF COMP.: OIL, GAS,
DRY HOLE, SWDW, ETC.:
Oil

Well No.
2-79

Lease Name
Mad1

S 14 T 16 R 21 E
Wx

WELL LOG

Show all important zones of porosity and contents thereof; cored intervals, and all drill-stem tests, including depth interval tested, cushion used, time tool open, flowing and shut-in pressures, and recoveries.

SHOW GEOLOGICAL MARKERS, LOGS RUN, OR OTHER DESCRIPTIVE INFORMATION.

FORMATION DESCRIPTION, CONTENTS, ETC.	TOP	BOTTOM	NAME	DEPTH
Soil and clay	0	16		
shale	16	163		
lime	163	170		
shale	170	174		
lime	174	184		
shale	184	193		
lime	193	200		
shale	200	204		
lime	204	224		
shale	224	270		
lime	270	277		
shale	277	353		
lime	353	375		
shale	375	393		
lime	393	400		
shale	400	429		
lime	429	441		
shale	441	463		
lime	463	485		
shale	485	490		
lime	490	516		
shale	516	519		
lime	519	532		
shale	532	750		
lime & shale	750	754		
lime	754	775		
shale	775	580		
lime	780	790		
shale	790	793		
lime	793	796		
shale	796	798		
lime	798	801		
shale	801	802		
sand	802	806		
sandy shale	806	810		
shale	810	843		
sandy shale	843	846		
shale	846	870		

USE ADDITIONAL SHEETS, IF NECESSARY, TO COMPLETE WELL RECORD.

Date Received

Ruthy Richman
Signature

Bookkeeper

Title

2-4-80

Date