

STATE CORPORATION COMMISSION OF KANSAS
OIL & GAS CONSERVATION DIVISION

WELL COMPLETION OR RECOMPLETION FORM
ACO-1 WELL HISTORY

DESCRIPTION OF WELL AND LEASE

Operator: license # 9607
name Painter Oil Company
address 5865 Fairwood Lane
City: State: Zip Memphis, Tennessee 38119

Operator Contact Person Jerry Hardsaw
Phone 913-242-5332

Contractor: license # 6807
name Oil Drillers and Developers

Wellsite Geologist none
Phone

PURCHASER Square Deal Oil Company

Designate Type of Completion
 New Well Re-Entry Workover

Oil SWD Temp Abd
 Gas Inj Delayed Comp.
 Dry Other (Core, Water Supply etc.)

Old well info as follows:
Operator
Well Name
Comp. Date Old Total Depth

WELL HISTORY

Drilling Method: Mud Rotary Air Rotary Cable

2/18/85 2/20/85 4/10/85
Spud Date Date Reached TD Completion Date

1130'
Total Depth PBDT

Wireline Log Rec'd
Amount of Surface Pipe Set and Cemented at 42' feet

Multiple Stage Cementing Collar Used? Yes No

If Yes, Show Depth Set feet

If alternate 2 completion, cement circulated from feet depth to w/ SX cmt

TUBING RECORD size set at packer at

Date of Production 4/10/85
Producing method flowing pumping gas lift Other (explain)

Estimated Production Per 24 Hours	Oil	Gas	Water	Gas-Oil Ratio	Gravity
	3.0		.2%		26.0
	Bbls	MCF	Bbls	CFPB	

API NO. 15 - 059-23,802

County Franklin

E/2 SW 1/4 (location) Sec 28 Twp 15 Rge 20 XX East West

635 FSL 1815 Ft North from Southeast Corner of Section
3288 FEL 2465 Ft West from Southeast Corner of Section
(Note: locate well in section plat below)


Lease Name Harry Scott Well# 17

Field Name IN-Field

Producing Formation First Squirrel

Elevation: Ground 945' KB

Section Plat

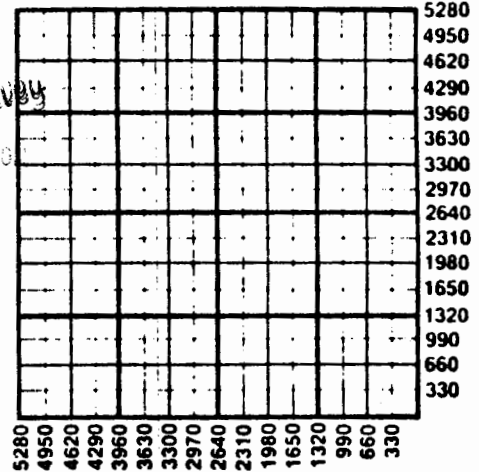

RECEIVED SURVEY
STATE CORPORATION COMMISSION
WICHITA BRANCH
JUN 24 1985
CONSERVATION DIVISION
Wichita, Kansas

WATER SUPPLY INFORMATION

Source of Water:

Division of Water Resources Permit #

Groundwater Ft North From Southeast Corner and Ft. West From Southeast Corner of (Well) Sec Twp Rge East West

Surface Water Ft North From Southeast Corner and Ft West From Southeast Corner (Stream, Pond etc.) Sec Twp Rge East West

Other (explain) (purchased from city, R.W.D.#)

Disposition of Produced Water: Disposal
Liner Run Yes No

PRODUCTION INTERVAL

WELL LOG

INSTRUCTIONS: Show important tops and base of formations penetrated. Detail all cores. Report all drill stem tests giving interval tested, time tool open and closed, flowing and shut-in pressures, whether shut-in pressure reached static level, hydrostatic pressures, bottom hole temperature, fluid recovery, and flow rates if gas to surface during test. Attach extra sheet if more space is needed. Attach copy of log.

Drill Stem Tests Taken Yes No
 Samples Sent to Geological Survey Yes No
 Cores Taken Yes No

Formation Description
 Log Sample

			Name	Top	Bottom
Topsoil & Clay	0'	40'	Shale	640'	644'
Shale	40'	87'	Lime	644'	649'
Lime	87'	93'	Shale	649'	656'
Shale	93'	99'	Lime	656'	663'
Lime	99'	112'	Shale	663'	685'
Shale	112'	118'	Lime	685'	691'
Lime	118'	128'	Shale	691'	703'
Shale	128'	131'	Ft. Scott Lime	703'	709'
Lime	131'	150'	Shale	709'	719'
Shale	150'	179'	Oil Sand	719'	727'
Lime	179'	198'	Shale	727'	837'
Shale	198'	279'	Sandy Shale	837'	852'
Lime	279'	302'	Shale	852'	904'
Shale	302'	324'	Sandy Shale	904'	927'
Lime	324'	332'	Lime	927'	930'
Shale	332'	351'	White Sandy Shale	930'	997'
Lime	351'	365'	White Sand	997'	1007'
Shale	365'	368'	Sandy Shale	1007'	1090'
Lime	368'	370'	Mississippi	1090'	1130'
Shale	370'	384'			
Lime	384'	391'			
Shale	391'	394'			
Lime	394'	408'			
Shale	408'	413'			
Lime	413'	440'			
Shale	440'	444'			
Lime	444'	448'			
Shale	448'	451'			
Lime	451'	457'			
Shale	457'	615'			
Lime	615'	618'			
Oil Sand	618'	625'			
Sandy Shale	625'	629'			
Lime	629'	640'			

CASING RECORD new used

Report all strings set - conductor, surface, intermediate, production, etc.

Purpose of string	size hole drilled	size casing set (in O.D.)	weight lbs/ft.	setting depth	type of cement	# sacks used	type and percent additives
surface completion	9 5/8ths	6 7/8ths		42' 783'	portland	18	2% gel

PERFORATION RECORD

Acid, Fracture, Shot, Cement Squeeze Record

shots per foot	specify footage of each interval perforated	(amount and kind of material used)	Depth
2/ft.	721'-727'		