



STATE CORPORATION COMMISSION OF KANSAS
OIL & GAS CONSERVATION DIVISION
WELL COMPLETION OR RECOMPLETION FORM
ACO-1 WELL HISTORY
DESCRIPTION OF WELL AND LEASE

C

API NO. 15-091-21,639
County Johnson
Sec. 11 15 21 X East
West

Operator: License # 6142
Name Town Oil Co.
Address Rt. 4
Paola, KS. 66071
City/State/Zip

610 Ft North from Southeast Corner of Section
630 Ft West from Southeast Corner of Section
(Note: Locate well in section plat below)
Kampschroeder 2
Lease Name Well #

Purchaser

Field Name

Operator Contact Person Lester Town
Phone 913 294-2125

Producing Formation

Elevation: Ground KB


Contractor: License # 6142
Name Town Oil Co.

Wellsite Geologist
Phone

Designate Type of Completion
X New Well Re-Entry Workover
X Oil SWD Temp Abd
Gas Inj Delayed Comp.
X Dry Other (Core, Water Supply etc.)

If OWNO: old well info as follows:
Operator
Well Name
Comp. Date Old Total Depth

Section Plat

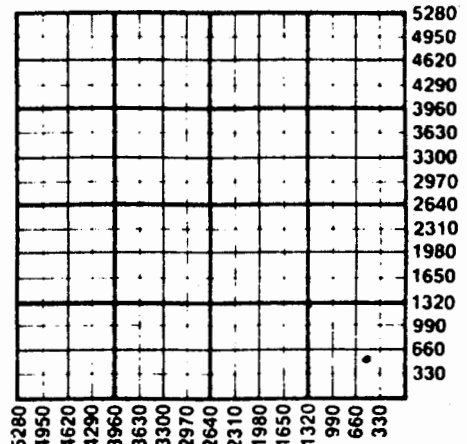

WATER SUPPLY INFORMATION

Disposition of Produced Water: Disposal
Docket # Repressuring

WELL HISTORY

Drilling Method:
Mud Rotary X Air Rotary Cable

10-2-85 10-5-85 3-25-86
Spud Date Date Reached TD Completion Date

907
Total Depth PBTD

Amount of Surface Pipe Set and Cemented at 42 feet
Multiple Stage Cementing Collar Used? Yes No
If yes, show depth set feet
If alternate 2 completion, cement circulated
from 42 feet depth to 0 w/.5 SX cmt
Cement Company Name
Invoice #

Questions on this portion of the ACO-1 call:
Water Resources Board (913) 296-3717

Source of Water:
Division of Water Resources Permit #

Groundwater Ft North from Southeast Corner
(Well) Ft West from Southeast Corner of
Sec Twp Rge East West

Surface Water Ft North from Southeast Corner
(Stream, pond etc) Ft West from Southeast Corner
Sec Twp Rge East West

Other (explain)
(purchased from city, R.W.D. #)

INSTRUCTIONS: This form shall be completed in triplicate and filed with the Kansas Corporation Commission, 200 Colorado Derby Building, Wichita, Kansas 67202, within 120 days of the spud date of any well. Rule 82-3-130, 82-3-107 and 82-3-106 apply.

Information on side two of this form will be held confidential for a period of 12 months if requested in writing and submitted with the form. See rule 82-3-107 for confidentiality in excess of 12 months. One copy of all wireline logs and drillers time log shall be attached with this form. Submit CP-4 form with all plugged wells. Submit CP-111 form with all temporarily abandoned wells.

08 1988

TOWN OIL COMPANY

11-15-21E

"Drilling and Production"

913-294-2125

Route 4

Pr Kansas 66071

Well No. 2

Farm: Kampschroeder

Johnson County, Kansas

Well Owner: Town Oil Co.

WELL LOG

Thickness of Strata	Formation	Total Depth
3	Soil	3
56	Clay	59
7	Lime	66
2	Sand	68
13	Lime	81
8	Shale	89
9	Lime (sandy)	98
4	Shale	102
20	Lime (sandy)	122
4	Shale & shells	126
3	Shale	129
3	Red bed	132
11	Shale	143
1	Lime	144
3	Shale	147
25	Lime	171
59	Shale	230
5	Lime	235
9	Shale	244
7	Lime	251
2	Shale	253
11	Lime	264
11	Shale	285
6	Lime	291
11	Shale	302
4	Lime	306
35	Shale	341
1	Lime	342
10	Shale	352
25	Lime	377
7	Shale & slate	384
23	Lime	407
5	Shale & slate	412
3	Lime	415
3	Shale & slate	418
6	Lime	424 Hertha
5	Shale	429
5	Shale & shells	434
14	Shale	448
26	Sandy shale	474
3	Sand	477
75	Sandy shale	558
20	Shale & shells	578
17	Sand	595

Well No. 2
 Farm: Kampschroeder
 Johnson County, Kansas
 Well Owner: Town Oil Co.

11-15-21E

WELL LOG (Cont'd)

Thickness of Strata	Formation	Total Depth
6	Lime	601
10	Shale & shells	611
2	Slate	613
4	Shale	617
3	Lime	620
5	Sand & shells	625
15	Shale	640
3	Lime	643
2	Slate	646
30	Shale & shells	676
2	Slate	678
4	Shale & shells	682
1	Lime	683
6	Shale & shells	699
3	Broken sand	702
29	Sandy shale	731
45	Shale & shells	776
2	Slate	778
45	Shale & shells	823
23	Sandy shale	846
2	Shale dk.	848
7	Shale & shells	855
7	Shale	862
4	Sand	866
16	Sandy shale	882
1	Broken sand	883
2	Broken sand	885
3	Sand	888
17	Shale	905
2	Slate	907 T.D.

583
 424
 459

RECORDED
 INDEXED
 OCT 2 1922
 TOWN OIL CO.