

12-15-21E

21

TYPE

AFFIDAVIT OF COMPLETION FORM*

ACQ-1 WELL HISTORY

SIDE ONE

Two (2) copies of this form shall be filed with the Kansas Corporation Commission, 200 Colorado Derby Building, Wichita, Kansas 67202, within thirty (30) days after the completion of a well, regardless of how the well was completed.

Attach separate letter of request if the information is to be held confidential. If confidential, only file one copy. Information on Side One will be of public record and Side Two will then be held confidential.

Applications must be made on dual completion, commingling, salt water disposal, injection and temporarily abandoned wells.

Attach one copy only wireline logs (i.e. electrical log, sonic log, gamma ray neutron log, etc.). (Rules 82-2-105 & 82-2-125) KCC# (316) 263-3238.

LICENSE # 6795 EXPIRATION DATE 6-30-85 YEARLY

OPERATOR PECK OIL CO INC. API NO. 15-091-21291

ADDRESS 12828 W. 66 TERRACE COUNTY JOHNSON

FIELD GARDNER-EDGERTON

** CONTACT PERSON R.C. PECK PROD. FORMATION BARTLESVILLE

PHONE 913/268-6878

PURCHASER LEASE KLAMM

ADDRESS WELL NO. #1

WELL LOCATION

DRILLING PECK OIL CO INC. 300 Ft. from S Line and

CONTRACTOR 700 Ft. from W Line of

ADDRESS 12828 W. 66 TERRACE the SW (Qtr.) SEC 12 TWP 15 RGE 21E

SHAWNEE, KAN. 66216

PLUGGING McMULLIN WELL SERVICE

CONTRACTOR RR #1

ADDRESS

WELLSVILLE, KAN 66092

TOTAL DEPTH 880 PBTD

SPUD DATE 5-7-84 DATE COMPLETED 6-28-84

ELEV: GR 1005 DF KB

DRILLED WITH (CABLE) (ROTARY) (AIR) TOOLS.

DOCKET NO. OF DISPOSAL OR REPRESSURING WELL BEING USED TO DISPOSE OF WATER FROM THIS LEASE

Amount of surface pipe set and cemented 39' 11" DV Tool Used?

THIS AFFIDAVIT APPLIES TO: (Circle ONE) Oil ^{AC-KCC} Gas, Shut-in Gas, Dry, Disposal, Injection, Temporarily Abandoned, OWWO. Other


ALL REQUIREMENTS OF THE STATUTES, RULES AND REGULATIONS PROMULGATED TO REGULATE THE OIL AND GAS INDUSTRY HAVE BEEN FULLY COMPLIED WITH.

WELL PLAT

(Office Use Only)

KCC ☒
KGS ☐

SWD/REP ☐
PLG. ☐

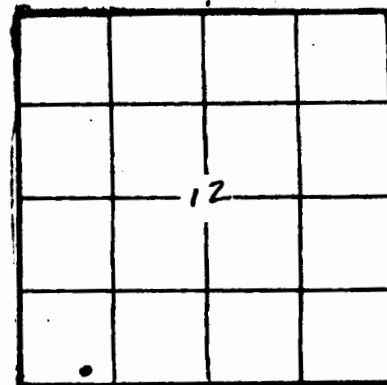

A F F I D A V I T

R.C. PECK, being of lawful age, hereby certifies that:

I am the Affiant, and I am familiar with the contents of the foregoing Affidavit. The statements and allegations contained therein are true and correct.

~ ~ ~ ~ ~

SIDE TWO

ACO-1 WELL HISTORY

OPERATOR PECK OIL CO, INC. LEASE KLAMM #1 SEC. 12 TWP. 15 RGE. 21e

FILL IN WELL LOG AS REQUIRED:

Show all important zones of porosity and contents thereof; cored intervals, and all drill-stem tests, including depth interval tested, cushion used, time tool open, flowing and shut-in pressures, and recoveries.

SHOW GEOLOGICAL MARKERS, LOGS RUN, OR OTHER DESCRIPTIVE INFORMATION.

FORMATION DESCRIPTION, CONTENTS, ETC.	TOP	BOTTOM	NAME	DEPTH
CLAY	0	25		
SHALE + LIME	25	403		
LIME	403	410	HERTHA	
SHALE	410	435		
SANDY SHALE	435	440	KNOB TOWN	
SHALE	440	553		
LIME + SHALE	553	686		
SANDY SHALE	686	696	1ST SQUIRREL	
SHALE	696	742		
SAND GAS	742	752	2ND SQUIRREL	
SHALE + LIME STREAKS	752	878		
BROKEN OIL SAND	878	888	BARTLESVILLE	
			300 FSL	
			700 FWL	

Report of all strings set—surface, intermediate, production, etc. CASING RECORD (New) or (Used)

Purpose of string	Size hole drilled	Size casing set (in O.D.)	Weight lbs/ft.	Setting depth	Type cement	Sacks	Type and percent additives
SURFACE	9 5/8	6 1/4	—	39'-11"	PORTLAND	11	—
PRODUCTION	5 1/8	NONE	—	—	—	—	—

LINER RECORD

PERFORATION RECORD

Top, ft.	Bottom, ft.	Sacks cement	Shots per ft.	Size & type	Depth interval
—	—	—	—	—	—

TUBING RECORD