


KANSAS

WELL COMPLETION REPORT AND DRILLER'S LOG

API No. 15 - 059 - 21,940 State Geological Survey WICHITA BRANCH

S. 29 T. 15 R. 21 E. Loc. 330 WEL 165 NSL SE SE SE County Franklin

Operator: Elton R. Greer
Address: Route # 1, Wellsville, Kansas 66092
Well No. 2 Lease Name Moldenhauer
Footage Location: 330 WEL 165 NSL
Principal Contractor: E. R. Greer Geologist: E. R. Greer
Spud Date: 6-4-81 Date Completed: 6-8-81 Total Depth: 785
Directional Deviation: Oil and/or Gas Purchaser:

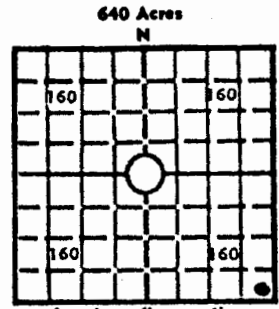

Elev.: Gr. DF KB

CASING RECORD

Report of all strings set - surface, intermediata, production, etc.

Table with 8 columns: Purpose of string, Size hole drilled, Size casing set (in O.D.), Weight lbs/ft., Setting depth, Type cement, Sacks, Type and percent additives. Row 1: Surface, 8 1/2", 6 1/4", 24, 104, Portland, 8.

LINER RECORD

PERFORATION RECORD

Tables for LINER RECORD and TUBING RECORD. LINER RECORD columns: Top, ft., Bottom, ft., Sacks cement. TUBING RECORD columns: Size, Setting depth, Packer set at.

ACID, FRACTURE, SHOT, CEMENT SQUEEZE RECORD

Table with 2 columns: Amount and kind of material used, Depth interval treated.

INITIAL PRODUCTION

Date of first production, Producing method (flowing, pumping, gas lift, etc.), RATE OF PRODUCTION PER 24 HOURS (Oil, Gas, Water), Gas-oil ratio, CFPB, Disposition of gas (vented, used on lease or sold), Producing interval (s)

INSTRUCTIONS: As provided in KCC Rule 82-2-125, within 90 days after completion of a well, one completed copy of this Drillers Log shall be trans-

Operator Elton R. Greer		DESIGNATE TYPE OF COMP.: OIL, GAS, DRY HOLE, SWDW, ETC.: Dry Hole
Well No. 1	Lease Name Moldenhauer	
S 29 T 15 R 21 E		

WELL LOG

Show all important zones of porosity and contents thereof; cored intervals, and all drill-stem tests, including depth interval tested, cushion used, time tool open, flowing and shut-in pressures, and recoveries.

SHOW GEOLOGICAL MARKERS, LOGS RUN, OR OTHER DESCRIPTIVE INFORMATION.

FORMATION DESCRIPTION, CONTENTS, ETC.	TOP	BOTTOM	NAME	DEPTH
Soil and clay	0	87		
lime	87	113		
shale	113	119		
lime	119	156		
shale	156	191		
lime	191	209		
shale	209	287		
lime	287	309		
shale	309	330		
lime	330	338		
shale	338	408		
lime	408	415		
shale	415	421		
lime	421	431		
shale	431	440		
lime	440	450		
shale	450	456		
lime	456	470	Base of Hertha	
shale	470	647		
lime	647	653		
shale	653	661		
lime	661	668		
shale	668	698		
lime	698	723		
shale	723	729		
lime	729	739	Base of Ft. Scott	
shale	739	785	Total Depth	

USE ADDITIONAL SHEETS, IF NECESSARY, TO COMPLETE WELL RECORD.

Date Received	<i>Elton R. Greer</i> Signature
	<i>Owner</i> Title
	<i>6-22-81</i> Date