

32-15-21E

Handwritten initials

This form shall be filed in duplicate with the Kansas Corporation Commission, 200 Colorado Derby Building, Wichita, Kansas 67202, within ten days after the completion of the well, regardless of how the well was completed.

Attach separate letter of request if the information is to be held confidential. If confidential, only file one copy. Information on side one will be of public record and side two will then be held confidential.

Circle one: Oil, Gas, Dry, SWD, OWWO, Injection. Type and complete ALL sections. Applications must be filed for dual completion, commingling, SWD and injection, T.A.

Attach wireline logs (i.e. electrical log, sonic log, gamma ray neutron log, etc.). KCC # (316) 263-3238. (Rules 82-2-105 & 82-2-125)

OPERATOR JOHN T. CASADY 7115

API NO. 15-059-22,706

ADDRESS Box 63

COUNTY Franklin

WELLSVILLE KS 66092

FIELD Paola-Raintoul

**CONTACT PERSON Same

PROD. FORMATION NA

PHONE

LEASE Coons

PURCHASER NA

WELL NO. 19

ADDRESS State Geological Survey WICHITA BRANCH

WELL LOCATION NW SW SW - 1000

DRILLING CONTRACTOR Casady Drilling

1155 Ft. from S Line and

ADDRESS 1632 Chestnut


475 Ft. from W Line of

Ottawa, KS 66067

the 32 SEC. 15 TWP. 21 ERGE. NW 1/4

WELL PLAT

PLUGGING CONTRACTOR Casady Drilling

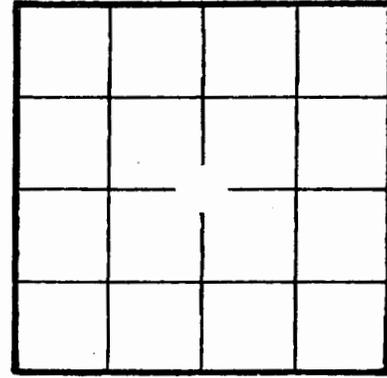

KCC [] KGS [x] (Office Use)

ADDRESS same

TOTAL DEPTH 750 PBT

SPUD DATE 20 Aug 82 DATE COMPLETED 23 Aug 82

ELEV: GR DF KB

DRILLED WITH (CABLE) (ROTARY) (AIR) TOOLS

Amount of surface pipe set and cemented 50' DV Tool Used?

AFFIDAVIT

STATE OF KANSAS, COUNTY OF FRANKLIN SS, I, John T.

Casady OF LAWFUL AGE, BEING FIRST DULY SWORN UPON HIS OATH,

DEPOSES THAT HE IS (FOR)(OF)

OPERATOR OF THE Coons LEASE, AND IS DULY AUTHORIZED TO MAKE

THIS AFFIDAVIT FOR AND ON THE BEHALF OF SAID OPERATOR, THAT WELL NO. 19 ON

SAID LEASE HAS BEEN COMPLETED AS OF THE 23rd DAY OF August, 1982, AND THAT

RECEIVED STATE CORPORATION COMMISSION