


Done

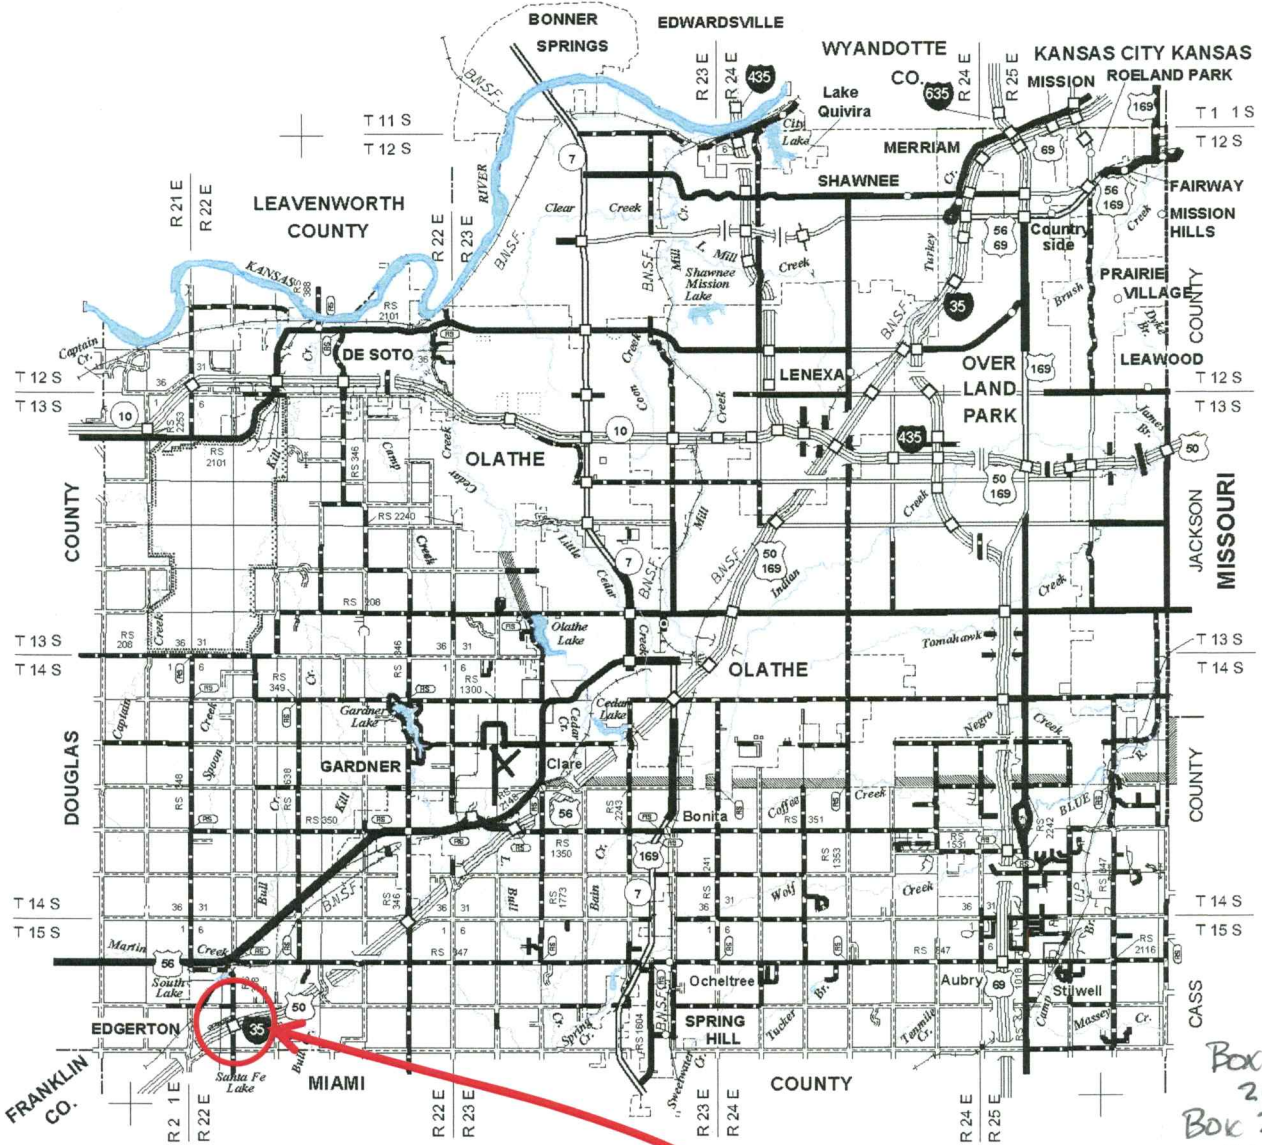

Box 1: 10.8 - 21.75
 Box 2: 21.75 - 33.2
 Box 3: 33.2 - 44.0
 Box 4: 44.03 - 53.2

Hole: 2
 STA: 149+25, 26 Rt
 Sunflower Rd over I-35
 3-31-15
 Box 1: 10.5 - 21.9
 Box 2: 21.9 - 32.4
 Box 3: 32.4 - 42.4

STA: 214+67 79' RT @ I-35

10-17-13

35-46 KA-3083-01
 Bridge No. 35-46-1.03(423)
 Sunflower Rd over I-35
 1.03 miles Northeast of Johnson/Miami Co. Line
 Johnson County

4 Boxes
 Well 1
 38.746448
 -95.000759

I R Sec
 15 S 22 E 17