

33-15-22E


#2 O.D. Werner

Sec. 33-15-22E
Johnson Co., Kansas
O.D. Werner #2

Comm. 3-4-29
Comp. 3-9-29

8 1/4" 14'

9 soil clay	9
6 lime boulders	15
21 gray lime	36
4 gray shale	40
39 gray lime	79
20 gray shale	99
10 gray lime	109
11 sandy lime	120
6 gray shale	126
3 red bed	129
9 gray shale	138
5 gr lime	143
12 dk shale	155
18 sandy shale	173
13 gray lime	186
2 dk shale	188
3 gray lime	191
8 gr shale	199
31 gray lime	230
3 gray shale	233
2 gray lime	235
1 blk slate	236 Little water
18 gray lime	254
4 blk slate	258 Water
3 gray lime	261
9 dk shale	270 Reduced hole 279'
8 gray lime	278 Hertha L M (SLM)
10 light shale	288
3 sand	291 Little gas
9 sandy shale	300
85 gray shale	385
15 sandy shale	400 L M 495 (SLM)
8 light shale	408
2 sand	410 Little gas
7 gray shale	417
1 gray lime	418
22 gray shale	440 Water at 445
3 sand	443
7 sandy shale	450
3 gray lime	453
2 gray shale	455
4 gr lime	459
7 light shale	466
1 gray lime	467
3 light shale	470
14 dk gray lime	484 L M 474-3 (SLM)
4 sandy shale	488
6 dk shale	490
4 lime	498
2 bl slate	500

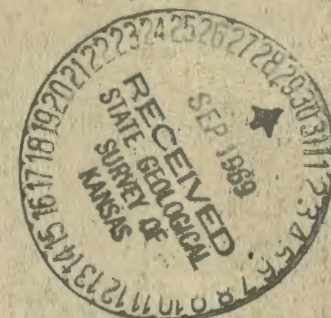

Packer set at 496'
Cage at 499-4 & Hencroft