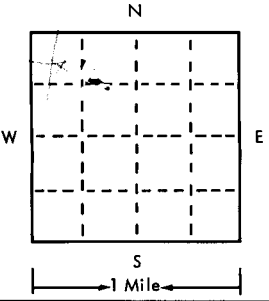


USE TYPEWRITER OR BALL
POINT PEN-PRESS FIRMLY,
PRINT CLEARLY.

GAS
WATER WELL RECORD
KSA 82a-1201-1215

T R EW sec 1/4 1/4 1/4 No.

Kansas State Dept. Of Health
(Water Well Contractors)
Forbes-Bldg. 740
Topeka, Kansas 66620

1 Location of well:	County Miami	Township name	Fraction SW 1/4 NE 1/4 NW 1/4	Section number 25	Town number 15 S	Range number 22E	
Distance and direction from nearest town or city:			3 Owner of well: John Bryan	
Street address of well location if in city:			Address: Rt. #1 Box 132 Gardner, Kansas	
Locate with "X" in section below: 			Sketch map:			4 Well depth: 700' ft. Date of completion: 11-7-74 Well diameter: 12 1/2 in.	
<table border="1"><thead><tr><th>2</th><th>Type and color of material</th><th>From</th><th>To</th></tr></thead><tbody><tr><td></td><td>clay</td><td>0</td><td>1</td></tr><tr><td></td><td>lime</td><td>1</td><td>11</td></tr><tr><td></td><td>shale</td><td>11</td><td>18</td></tr><tr><td></td><td>shale red</td><td>18</td><td>21</td></tr><tr><td></td><td>shale</td><td>21</td><td>32</td></tr><tr><td></td><td>lime</td><td>32</td><td>51</td></tr><tr><td></td><td>shale</td><td>51</td><td>77</td></tr><tr><td></td><td>lime</td><td>77</td><td>79</td></tr><tr><td></td><td>shale</td><td>79</td><td>136</td></tr><tr><td></td><td>lime</td><td>136</td><td>141</td></tr><tr><td></td><td>shale</td><td>141</td><td>144</td></tr><tr><td></td><td>lime</td><td>144</td><td>162</td></tr><tr><td></td><td>shale</td><td>162</td><td>188</td></tr><tr><td></td><td>shale red</td><td>188</td><td>192</td></tr><tr><td></td><td>shale</td><td>192</td><td>195</td></tr><tr><td></td><td>lime</td><td>195</td><td>200</td></tr><tr><td></td><td>shale</td><td>200</td><td>245</td></tr><tr><td></td><td>lime</td><td>245</td><td>246</td></tr><tr><td></td><td>shale</td><td>246</td><td>258</td></tr><tr><td></td><td>lime</td><td>258</td><td>285</td></tr><tr><td></td><td>shale</td><td>285</td><td>288</td></tr><tr><td></td><td>slate black</td><td>288</td><td>290</td></tr><tr><td></td><td>lime</td><td>290</td><td>311</td></tr><tr><td></td><td>shale</td><td>311</td><td>315</td></tr><tr><td></td><td>lime</td><td>315</td><td>321</td></tr>lime	315	321	5 ☐ Cable tool ☒ Rotary ☐ Driven ☐ Dug ☐ Hollow rod ☐ Jetted ☐ Bored ☐ Reverse rotary		
			6 Use: ☐ Domestic ☐ Public supply ☐ Industry ☐ Irrigation ☐ Air conditioning ☐ Commercial ☐ Test well ☐ GAS - Dry	
			7 Casing: Material _____ Height: above/below _____ Threaded ☐ Welded ☐ Surface _____ in. Diam. _____ Weight _____ lbs./ft. _____ _____ in. to _____ ft. depth Drive shoe? ☐ Yes ☐ No _____ in. to _____ ft. depth	
			8 Screen: Manufacturer _____ Type _____ Dia. _____ Slot/gauze _____ Length _____ Set between _____ ft. and _____ ft. _____ Fittings: Gravel pack ☐ Yes ☐ No Size range of material _____	
			9 Static water level: _____ ft. below land surface Date _____	
			10 Pumping level below land surfaces: _____ ft. after _____ hrs. pumping _____ g.p.m. _____ ft. after _____ hrs. pumping _____ g.p.m. Estimated maximum yield _____ g.p.m.	
			11 Water sample submitted: ☐ Yes ☐ No Date _____	
			12 Well head completion: ☐ Pitless adapter ☐ Inches above grade	
			13 Well grouted? ☐ Yes ☐ No ☐ Neat cement ☐ Bentonite ☐ _____ Depth: From _____ ft. to _____ ft.	
			14 Nearest source of possible contamination: ft. _____ Direction _____ Type _____ Well disinfected upon completion? ☐ Yes ☐ No	
			15 Pump: ☒ Not installed Manufacturer's name _____ Model number _____ HP _____ Volts _____ Length of drop pipe _____ ft. capacity _____ g.p.m. Type: ☐ Submersible ☐ Turbine ☐ Jet ☐ Reciprocating ☐ Centrifugal ☐ Other	
16 Remarks: elevation 1015 Topography: ☐ Hill ☐ Slope ☒ Upland ☐ Valley			17 Water well contractor's certification: This well was drilled under my jurisdiction and this report is true to the best of my knowledge and belief. Cullum & Brown, Inc. Business name _____ License No. _____ Address 1240 Burlington Ave. Mo. Signed [Signature] Date 11-14-74 Authorized representative	

Forward the white, blue and pink copies to the Kansas State Dept. Of Health.

Form WWC-5


USE TYPEWRITER OR BALL
POINT PEN—PRESS FIRMLY,
PRINT CLEARLY.

GAS
WATER WELL RECORD
KSA 82a-1201-1215

T R EW sec 1/4 1/4 1/4 No.

Kansas State Dept. Of Health
(Water Well Contractors)
Forbes-Bldg. 740
Topeka, Kansas 66620

Page 2

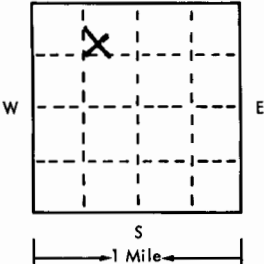1 Location of well:	County Miami	Township name	Fraction SW 1/4 NE 1/4 NW 1/4	Section number 25	Town number T 15 S	Range number R 22 E
Distance and direction from nearest town or city:				3 Owner of well: John Bryan		
Street address of well location if in city:				Address: Rt #1 Box 132 Gardner, Kansas		
Locate with "X" in section below:		Sketch map:		4 Well depth: _____ ft. Date of completion _____ Well diameter _____ in.		
				5 ☐ Cable tool ☐ Rotary ☐ Driven ☐ Dug ☐ Hollow rod ☐ Jetted ☐ Bored ☐ Reverse rotary		
2		Type and color of material		6 Use: ☐ Domestic ☐ Public supply ☐ Industry ☐ Irrigation ☐ Air conditioning ☐ Commercial ☐ Test well ☐ _____		
				7 Casing: Material _____ Height: above/below Threaded ☐ Welded ☐ Surface _____ in. Diam. _____ Weight _____ lbs./ft. _____ in. to _____ ft. depth Drive shoe? ☐ Yes ☐ No _____ in. to _____ ft. depth		
				8 Screen: Manufacturer _____ Type _____ Dia. _____ Slot/gauze _____ Length _____ Set between _____ ft. and _____ ft. _____ Fittings: Gravel pack ☐ Yes ☐ No Size range of material _____		
				9 Static water level: _____ ft. below land surface Date _____		
				10 Pumping level below land surfaces: _____ ft. after _____ hrs. pumping _____ g.p.m. _____ ft. after _____ hrs. pumping _____ g.p.m. Estimated maximum yield _____ g.p.m.		
				11 Water sample submitted: ☐ Yes ☐ No Date _____		
				12 Well head completion: ☐ Pitless adapter ☐ Inches above grade		
				13 Well grouted? ☐ Yes ☐ No ☐ Neat cement ☐ Bentonite ☐ _____ Depth: From _____ ft. to _____ ft.		
				14 Nearest source of possible contamination: ft. _____ Direction _____ Type _____ Well disinfected upon completion? ☐ Yes ☐ No		
				15 Pump: ☐ Not installed Manufacturer's name _____ Model number _____ HP _____ Volts _____ Length of drop pipe _____ ft. capacity _____ g.m.p. Type: ☐ Submersible ☐ Turbine ☐ Jet ☐ Reciprocating ☐ Centrifugal ☐ Other		
16 Remarks: elevation		lime shale TD		17 Water well contractor's certification: This well was drilled under my jurisdiction and this report is true to the best of my knowledge and belief. William Brown Business name _____ License No. _____ Address _____ Signature _____ Date _____ Authorized representative		

Forward the white, blue and pink copies to the Kansas State Dept. Of Health.

Form WWC-5