

H.L. Ferrell 8/22/29

GEOLOGICAL DEPARTMENT
UNION GAS CORPORATION

INDEPENDENCE, KANSAS

Company C. E. S. Ramey et al, Springhill, Kns.

S. T. R.
County
State
Lease and
Well No.

15-15-23
Johnson
Kansas
Ramey #1

Contractor Ed. Smith, Olathe, Kansas.

Drilling Commenced Aug. 6, 1929

Drilling Completed Aug. 14, 1929

Initial Production 76,000 gas


Initial Rock Pressure 90'

Location 1300' N. and 1100' E. of SW corner of SW 1/4

Casing

SE NW SW

N

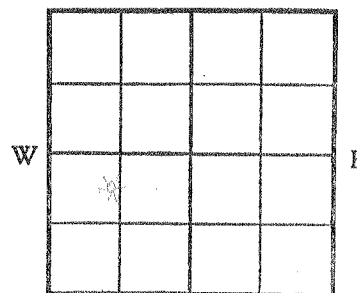

S

Driller's Record of Formations

	soil	5
3	lime	8
10	black shale	18
15	shale	33
24	lime	57
114	shale	171
26	lime	197
8	shale	205
5	lime	210
10	shale	220
3	red rock	223
14	shale	237
6	lime	243
33	shale	276
2	lime	278
12	shale	290
22	lime	312
5	shale dark	317
4	lime	321
5	shale light	326
8	lime	334
2	shale light	336
14	lime	350
7	shale black	357
7	lime	364 little gas
5	shale	369
176	shale	545
10	sandy lime	555
6	lime	561
6	shale white set 6 1/2"	567 S.L.N.
13	shale	580
4	lime	584 gas 76,000 at 584'
5	shale dark	589 T.D.

Drilled for use at house.