


Section 23 Township 15 Range 9 EWell No. #1 C. V. Kieffer
#2 OlsonCompany Gruenerwald

NORTH

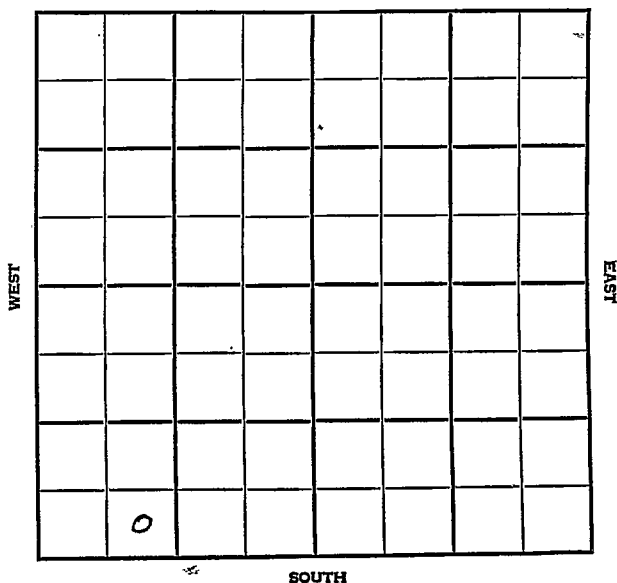

Morris

KANSAS

SEC.	TWP.	R..
23	15	9E

WELL NO. #1 C.V. Kieffer
#2 Olson

FARM

COMPANY

Gruenerwald

CONTRACTOR

White & Ellis

John Creek


_____ Ft. from N. Line

330 _____ Ft. from S. Line

_____ Ft. from E. Line

990 _____ Ft. from W. Line

SE SW SW

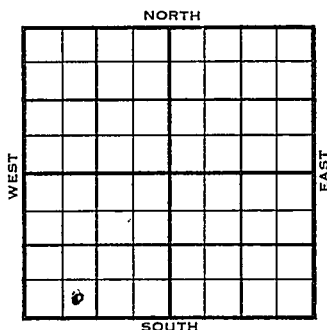

1955

ELEVATION

REPORT

10/5

M I R

DX-201

No County

TWP.

R.

23

15

9E

WELL NO.

1 G. V. Kieffer

FARM

COMPANY

Gruenerwald

CONTRACTOR

CORRECTION

SE SW SW

NORTH


_____ FT. FROM N. LINE

330

_____ FT. FROM S. LINE

FT. FORM E. LINE

990 FT. FROM W. LINE

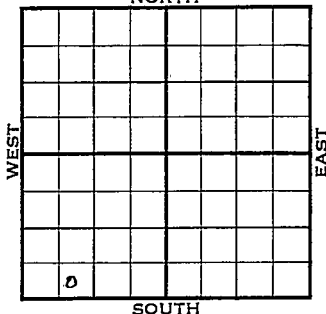

Morris County



LOCATION

--	--

RIG UP

DRILLING AND REMARKS:

Reported

#2 Olson

RECORD

CASED IN.. FT.

SAND

GAS

OIL

TOTAL DEPTH

1ST 24 HRS. NAT.

1ST 24 HRS. AFTER SHOT

GAS	CU. FT.
-----	---------

DRY HOLE

ABANDONED

PRODUCTION

DATE _____

SCOUT

OCT 1 2 1954

L. J. Harris

County

Morris

Elev.

Sec.

23

Twp.

15

Rge.

9E

Company

Gruenerwald

Farm Name

Olson

No.

2

TOPS

DEPTH

LOG

DATUM

Loc. in Sec.

Anh.

Tp.

H.

Tr.

Dg.

BL.

L.

K.C.

B.K.C.

Ce.

C.

M.

M.

K.

Mz.

Mq.

V.

S.

S.

A.

R.

P.E.

G.

T.D.

SE SW SW

Geol.

Contr.

White & Ellis

Pool

John Creek

FIRST REPORT

OCT 5 '52

0

Date Comm.

M I R