

Hummer

UNION GAS CORPORATION
GEOLOGICAL DEPARTMENT
SOUTHWESTERN GAS COMPANY
INDEPENDENCE, KANSAS

Company

S. T. R.
County
State
Lease and
Well No.

8-15-25
Johnson
Kansas
J. E. Larkin #1

Contractor Earl Hummer

Drilling Commenced May, 1927


Drilling Completed

Initial Production

Initial Rock Pressure

Location NE $\frac{1}{4}$ of SE $\frac{1}{4}$

Casing

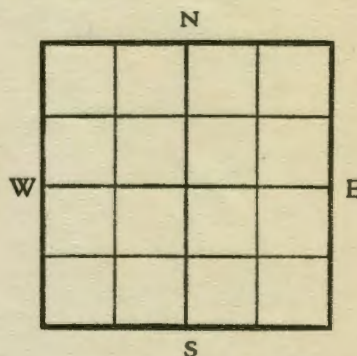

Driller's Record of Formations

5	soil	5
5	clay	10
3	sand	13
37	shale	50
40	lime	90
25	shale	115
15	lime	130
24	shale	154
6	lime	160
32	shale	192
10	lime	202
12	shale	214
29	lime	243
5	shale	248
22	lime	270
3	shale	273
8	lime	281
5	shale	286
5	sand gas	291
1	sand gas	292
110	shale	402
10	sand	412
50	shale	462
13	lime	475
20	shale	495
6	lime	501
5	gas sand	506
3	shale	514
4	lime	518
7	blue shale	525
6	red shale	531 T.D.