

County **Dickinson** State **Kansas**
 Sec. **13** (Blk. Twp.) **15** (Sur. Rge.) **3E** Map No.
 Operator **J. H. Wagner**
 Well No. **1** Farm **Schlesener**
 Elev. Location **SE NW SE**




990 Ft. From **N** Line **SE**
990 Ft. From **W** Line **Quarter**
 Ist. Report **OCT 1 1953**
 Completion
 Remarks
Wagner - Contr.
 Spudding Date **10-2-53**

Drlg. Data **Wildcat**
12" @ 206 1 blr. wtr. 650-60 1 1/2 blr. wtr.
1238-52 10" @ 1254 HFW 1405-20
drlg. 1475

J. G. McGEHEE

County **Dickinson** State **Kansas**
 Sec. **13** (Blk. Twp.) **15** (Sur. Rge.) **3E** Map No.
 Operator **J. H. Wagner**
 Well No. **1** Farm **Schlesener**
 Elev. **1350** Location **SE NW SE**

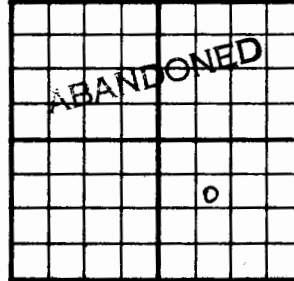

990 Ft. From **N** Line **SE**
990 Ft. From **W** Line **Quarter**
 Ist. Report
 Completion **NOV 4 1953**
 Remarks **Wildcat**
Wagner - Contr.
 Spudding Date **10-2-53**

Drlg. Data **D & A TD 2428**
12" @ 206 1 blr. wtr. 650-60 1 1/2 blr wtr.
1238-52 10" @ 1254 HFW 1405-20
8" @ 1710 KC 1960 6" @ 2324
Miss. 2338 TD 2428
D & A

J. G. McGEHEE

County **Dickinson** State **Kansas**
 Sec. **13** (Blk. **15** (Sur. **3E** Map No.
 Operator **J. H. Wagner**
 Well No. **1** Farm **Schlesener**
 Elev. Location **SE NW SE**




990 Ft. From **N** Line **SE**
990 Ft. From **W** Line Quarter
 1st. Report **OCT 1 1952**
 Completion
 Remarks **Wagner - Contr.**
 Spudding Date **10-2-53**

Drilg. Data **Wildcat**
12" @ 206 1 blr. wtr. 650-60 1 1/2 blr. wtr.
1238-52 10" @ 1254 HFW 1405-20
drilg. 1475

J. G. McGEHEE

County **Dickinson** State **Kansas**
 Sec. **13** (Blk. **15** (Sur. **3E** Map No.
 Operator **J. H. Wagner**
 Well No. **1** Farm **Schlesener**
 Elev. **1350** Location **SE NW SE**

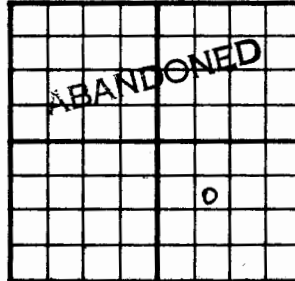

990 Ft. From **N** Line **SE**
990 Ft. From **W** Line Quarter
 1st. Report
 Completion **NOV 4 1952**
 Remarks **Wildcat**
Wagner - Contr.
 Spudding Date **10-2-53**

Drilg. Data **D & A TD 2428**
12" @ 206 1 blr. wtr. 650-60 1 1/2 blr wtr.
1238-52 10" @ 1254 HFW 1405-20
8" @ 1710 KC 1960 6" @ 2324
Miss. 2338 TD 2428

D & A

J. G. McGEHEE

Dickinson

KANSAS

SEC. 13 TWP. 15 R. 3E ✓

WELL NO.

#1 Schlesener

FARM

COMPANY

J.H. Wagner

CONTRACTOR

Wagner

Wildcat.

990

Ft. from N. Line


Ft. from S. Line

Ft. from E. Line

990

Ft. from W. Line

SE NW SE

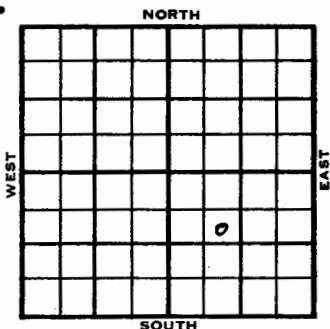

15-041-00003


FORM 51

Dickinson KANSAS

Section 13 Township 15 Range 3 E

Well No. # 1 Schlesener

Company J. H. Wagner

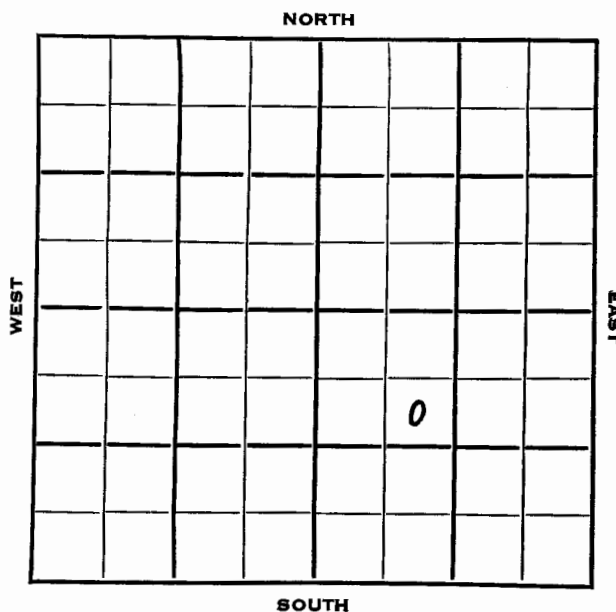

1953

ELEVATION

1350'

REPORT

10/14

Spud 10-2-53

12" @ 206'

1 blr. wtr. 650-60 1½ blr. wtr.

1238-52

10" @ 1254'

HFW 1405-20

Drlg 1475'

11/4

Spud 10-2-53 D & A TD 2428

12" @ 206 1 bbl wtr. 650-60'

1½ bblr wtr. 1238-52 10" @ 1254'

HFW 1405-20 8" @ 1710 KC 1960

6" @ 2324 Miss 2338'

TD 2428' D & A

ABANDONED

2338
1350
988

DX-78