

normal *Dickinson Co*
 Map No. **KANSAS** Sec. *17* Twp. *15* R. *4*
 Well No. *1* *Heardon*
Phillips Pet Co Company

Contractor

FIRST REPORTS

SECTION PLAT

990 Ft. from N. Line
 _____ Ft. from S. Line
330 Ft. from E. Line
 _____ Ft. from W. Line

			o

Location _____

Rig up _____

Drilling and Remarks:

ROS

RECORD

Cased _____ in., _____ ft.
 Sand _____
 Gas _____
 Oil _____
 Total Depth _____

PRODUCTION

1st 24 hrs. Nat. _____
 1st 24 hrs. after shot _____
 Gas _____ Cu. Ft.
 Dry Hole _____
 Abandoned _____

Date

MAY 18 1927 **CHAS. L. SHERWOOD**
 _____ 1927 _____ Scout

normal *Dickinson Co*
 Map No. **KANSAS** Sec. *17* Twp. *15* R. *4*
 Well No. *1* *Heardon*
Phillips Pet Co Company

Contractor

COMPLETED

SECTION PLAT

990 Ft. from N. Line
 _____ Ft. from S. Line
330 Ft. from E. Line
 _____ Ft. from W. Line

			o

ABANDONED

Location _____

Rig up _____

Drilling and Remarks:

197 2445

RECORD

Cased _____ in., _____ ft.
 Sand _____
 Gas _____
 Oil _____
 Total Depth *2445*

PRODUCTION

1st 24 hrs. Nat. _____
 1st 24 hrs. after shot _____
 Gas _____ Cu. Ft.
 Dry Hole *✓*
 Abandoned *✓*


Date

July 13 1927 **CHAS. L. SHERWOOD**
 _____ 1927 _____ Scout

MAP No. _____ SEC. 17 TWP. 15S R. 4E
 WELL No. 1 Reardon
Phillips Pet COMPANY

CONTRACTOR

SECTION PLAT

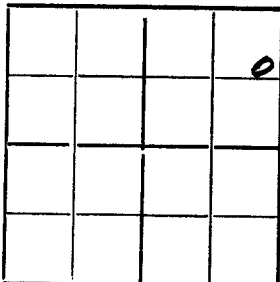

_____ FT. FROM N. LINE
 _____ FT. FROM S. LINE
 _____ FT. FROM E. LINE
 _____ FT. FROM W. LINE

LOCATION _____
 RIG UP _____
 DRILLING AND REMARKS:

RECORD
 CASED _____ IN. _____ FT.
 SAND _____
 GAS _____
 OIL _____
 TOTAL DEPTH 2445

PRODUCTION
 1ST 24 HRS. NAT. _____
 1ST 24 HRS. AFTER SHOT _____
 GAS _____ CU. FT.
 DRY HOLE ☒
 ABANDONED ☒


DATE

7-14 1929

SCOUT

Map No. Kansas Sec. 17 Twp. 15 R. 4E
 Well No. 1-Reardon Farm _____
Phillips Pet Company

NORTH

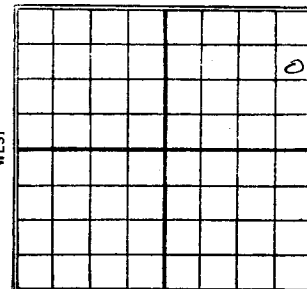

990 Ft. from N. Line
 _____ Ft. from S. Line
330 Ft. from E. Line
 _____ Ft. from W. Line

SOUTH

Date
1929

REPORT

5/18 R.O.G.
5/25 Spudding
6/1 Drlg 750
6/7 Drlg 1450
6/15 " 1790
6/22 " 2000
6/29 " 2301
7/13 D. & A. 2445

Form 51-5M-10-26-Mid-West

Map No.

Sec.

Sec. 17

Twp

15

R.

Well No.


1 Reardon

Farm

Phillips Pch

Company

NORTH

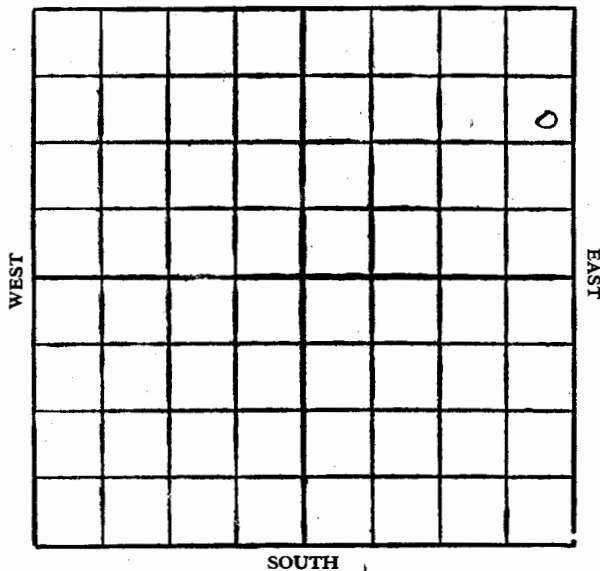[illegible]

Cased.....in.ft.
Sand
Gas
Oil
Total Depth.....

[illegible]

1st 24 hrs. Nat.....
1st 24 hrs. after shot.....
Gas..... cu. ft.
Dry Hole.....
Abandoned.....