

no map KANSAS

Map No. _____ Sec. 31 Twp. 15 R. 4 EWell No. 1 DunlapD. J. Hall Company

Contractor

FIELD REPORTS

SECTION PLAT

			o

_____ Ft. from N. Line

990 Ft. from S. Line330 Ft. from E. Line

_____ Ft. from W. Line

Location _____

Rig up _____

Drilling and Remarks:

Spudg

RECORD

Cased _____ in., _____ ft.

Sand _____

Gas _____

Oil _____

Total Depth _____

PRODUCTION

1st 24 hrs. Nat. _____

1st 24 hrs. after shot _____

Gas _____ Cu. Ft.

Dry Hole _____

Abandoned _____

Date

June 29 1927 CHAS. I. SHERWOOD ScoutMAP No. _____ SEC. 31 TWP. 15S R. 4EWELL No. 1 DunlapHall COMPANY

CONTRACTOR

no wall map

SECTION PLAT

			o

_____ FT. FROM N. LINE

_____ FT. FROM S. LINE

_____ FT. FROM E. LINE

_____ FT. FROM W. LINE

LOCATION _____

RIG UP _____

DRILLING AND REMARKS:

RECORD

CASED _____ IN., _____ FT.

SAND _____

GAS _____

OIL _____

TOTAL DEPTH. 7652

PRODUCTION

1ST 24 HRS. NAT. _____

1ST 24 HRS. AFTER SHOT _____

GAS _____ CU. FT.

DRY HOLE ✓ABANDONED ✓

DATE

11/27 1927 _____ SCOUT

Dickinson
 Map No. KANSAS Sec. 31 Twp. 15 R. 4
 Well No. 1 - Dunlap
D. T. Hall Company

Contractor

COMPLETED


SECTION PLAT

Ft. from N. Line

990 Ft. from S. Line330 Ft. from E. Line

Ft. from W. Line

ABANDONED

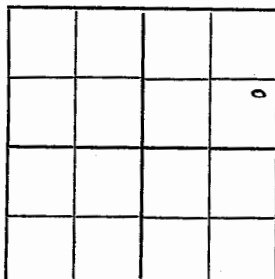

Location

Rig up

Drilling and Remarks:

Chat 2321-44H.F.W. 2341-44Sile line 2588-93 H.F.W.Depth 2654

RECORD

Cased _____ in., _____ ft.

Sand _____

Gas _____

Oil _____

Total Depth 2654

PRODUCTION

1st 24 hrs. Nat. _____

1st 24 hrs. after shot _____

Gas _____ Cu. Ft.

Dry Hole ☒

Abandoned _____

Date

NOV 2 - 1927 192 CHAS. L. SHERWOOD


Scout

*Dickinson*Map No. _____ Sec. 31 Twp. 15 R. 4 EWell No. 1 - Dunlap FarmD. T. Hall Company

Ft. from N. Line

990 Ft. from S. Line330 Ft. from E. Line

Ft. from W. Line

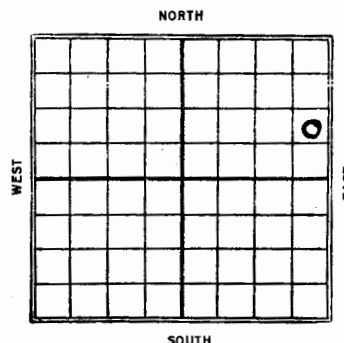1927


Date

REPORT

<u>6/29</u>	<u>Spudding</u>
<u>7/7</u>	<u>" 200'</u>
<u>7/13</u>	<u>"</u>
<u>7/20</u>	<u>Spudding 320</u>
<u>7/28</u>	<u>Drly 550</u>
<u>8/4</u>	<u>" 1100'</u>
<u>8/10</u>	<u>" 1350</u>
<u>8/18</u>	<u>" 1600'</u>
<u>8/24</u>	<u>S.A. 1755 - titles</u>
<u>9/1</u>	<u>"</u>
<u>9/7</u>	<u>"</u>
<u>9/14</u>	<u>"</u>
<u>9/29</u>	<u>" U.R. 6" - 2200</u>
<u>10/6</u>	<u>Chat 2321-44 H.F.W. - U.R.</u>
<u>10/12</u>	<u>Drly 2390</u>
<u>10/19</u>	<u>Det 5" - 2550</u>
<u>11/2</u>	<u>Chat 2321-44</u>
	<u>H.F.W. 234-44</u>
	<u>Sile. line 2588-93 H.F.W.</u>
	<u>D.T. 2654</u>

15-041-00136

Map No. _____ Sec. 31 Twp. 15 R. 4 E
 Well No. 1 - Dunlap Farm _____
D. I. Hall Company _____

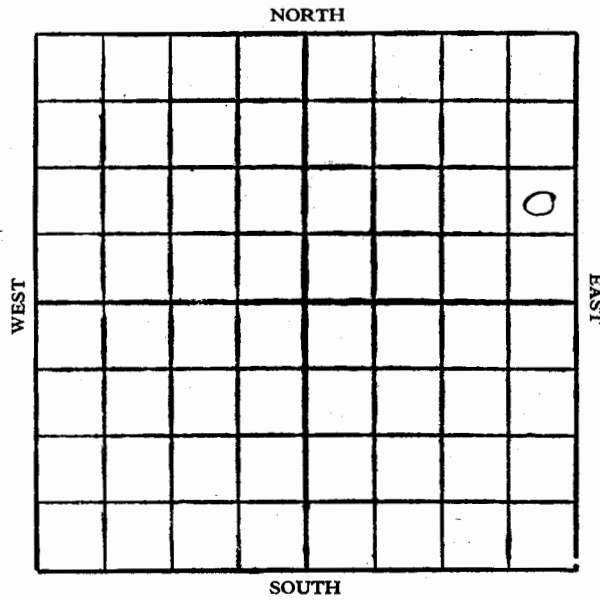

Location _____
 Drilling Remarks _____

Rig Up _____
 Drilling Remarks _____

RECORD

Cased _____ in. _____ ft.
 Sand _____
 Gas _____
 Oil _____
 Total Depth _____

PRODUCTION

1st 24 hrs. Nat. _____
 1st 24 hrs. after shot _____
 Gas _____ cu. ft.
 Dry Hole _____
 Abandoned _____