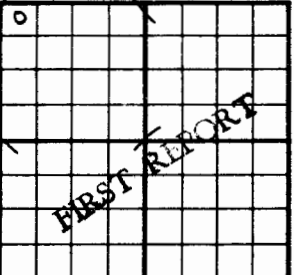
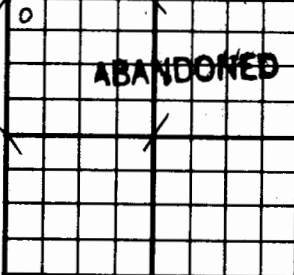


County	Morris	State	Kansas
Sec.	17 (Blk. Twp.)	15 (Sur. Rge.)	5E Map No.
Operator	F. G. Holl et al.		
Well No.	1	Farm	Whitehair
Elev.	Location NW NW NW		
			
330 Ft. From N Line NW			
330 Ft. From W Line Quarter			
1st. Report MAY 2 1951			
Completion			
Remarks			
B & R Drlg. - Contr.			
Spudding Date			

Drlg. Data Wildcat
Set surface

J. E. TYRA

County	Morris	State	Kansas
Sec.	17 (Blk. Twp.)	15 (Sur. Rge.)	5E Map No.
Operator	F. G. Holl et al.		
Well No.	1	Farm	Whitehair
Elev.	1394	Location NW NW NW	
			
330 Ft. From N Line NW			
330 Ft. From W Line Quarter			
1st. Report			
Completion AUG 15 1951			
Remarks Wildcat			
B & R Drlg. - Contr.			
Spudding Date			

Drlg. Data D & A TD 2205
Burgess sand 2161 DST 2161-69 Rec. mud
5" @ 2161 TD 2205 B KC 1970 Miss. 2166
DST 2162-80 open 1 hr. Rec. 52' socm
DST 2166-2205 open 40 min. Rec. 455'
water & mud CO to 2205 HFW PB 2195
test 7 bailers water per hr. PB 2184
4 bwph SSO PB 2179 S/4 gwph
20 qt/ 2162-67 2 go 4 gwph
D & A

J. E. TYRA

Morris

KANSAS

Sec. 17 Twp. 15 R. 5 E

Well No. # 1 Whitehair Farm

F. G. Holl et al Company

B & R Drlg. Contractor

Wildcat


330 Ft. from N. Line

_____ Ft. from S. Line

_____ Ft. from E. Line

330 Ft. from W. Line

NW NW NW

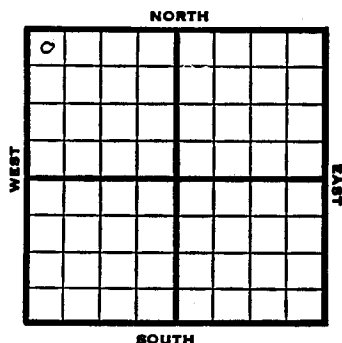

1951 Elev. 1394' REPORT

5/2 Set surface

8/15 D & A TD 2205'
Burgess sand 2161'
DST 2161-69 rec mud 5" @ 2161'
TD 2205' B KC 1970' Miss 2166'
DST 2162-80 open 1 hr. rec 52' SOCM
DST 2166-2205 open 40 min. rec 455'
water & mud. CO to 2205' HFW
PB 2195 Test 7 bailers water per hr
PB 2184' 4 BWPH SSO PB 2179'
S/4 GWPH 20 qt/2162-67 2 GO
4 GWPH
D & A

ABANDONED

Section 17 Township 15 Range 5 E

Well No. # 1 Whitehair

Company F. G. Holl et al

