

County Morris State Kansas
 Sec. 17 (Blk.) 15 (Sur.) 5E Map No.
 Operator Albert Pann & F. G. Holl

Well No. 1 Farm Gatch
 Elev. _____ Location SW NW NW

0							
ABANDONED							

 990 Ft. From N Line NW
 330 Ft. From W Line Quarter

 1st. Report
 Completion OCT 7 1953

 Remarks Wildcat
 Berentz - Contr.

 Spudding Date 9-26-53

 Drig. Data D & A TD 2180
 8" @ 146 B KC 1965 Burgess 2133
 Miss. 2140 DST 2140-80 open 1½ hr.
 Rec. 800' wtr. TD 2180
 D & A

J. G. McGEHEE

Morris KANSAS

SEC. 17 TWP. 15 R. 5 E

WELL NO. #1 ~~Hentshel~~ Gatch

COMPANY FARM

CONTRACTOR Albert Pann & F. G. Hall

Berentz Wildcat


990 Ft. from N. Line

Ft. from S. Line

Ft. from E. Line

330 Ft. from W. Line

SW NW NW

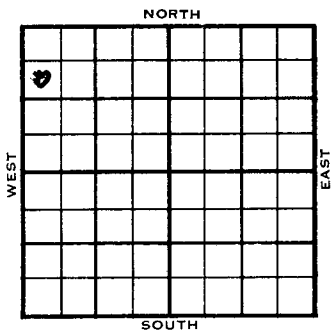

15-127-00078 Morris


FORM 51

Section 17 Township 15 Range 5E

Well No. #1 Hentshel Gatch

Company Albert Pann & F.G. Hall

NORTH

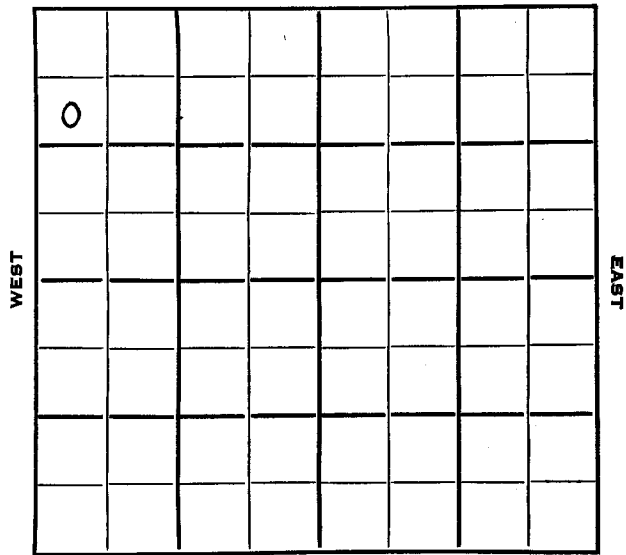

SOUTH

ELEVATION REPORT

1953 Elev. - 1354

9/23 Location

10/7 Spud 9-26-53 D & A TD 2180
 8" @ 146 B KC 1965 Burgess 2133
 Miss 2140
 DST 2140-80 open 1 1/2 hr rec 800' wtr.
 TD 2180' D & A

ABANDONED