



Morris KANSAS

Sec. 28 Twp. 15 R. 5 E ✓

Well No. # 1 Granzow Farm

Sohio Company

Veeder Contractor


Wildcat  
Ft. from N. Line

330 Ft. from S. Line

330 Ft. from E. Line

Ft. from W. Line

SE SE SW

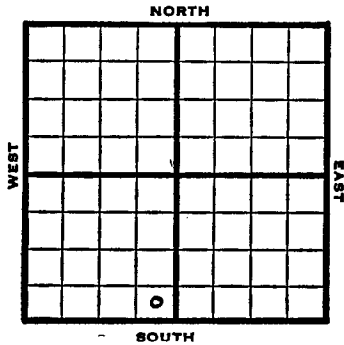


Morris KANSAS

Section 28 Township 15 Range 5 E

Well No. # 1 Granzow

Company Sohio

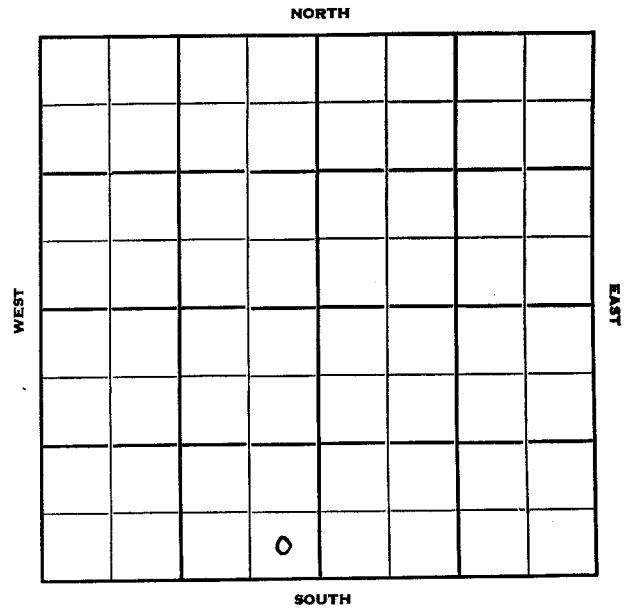

1951 Elev. - REPORT

2/28 Spud 2-23-51  
8" @ 160'  
Drlg. 1400

3/7 Spud 2-23-51  
D&A TD 2290  
8" @ 160  
Lans. 1665' Miss 2173  
TD 2290 D&A

ABANDONED