

County **Morris** State **Kansas**
 Sec. **29** (Blk. Twp.) **15** (Sur. Rge.) **5E** Map No.
 Operator **B & R Drlg. & Schio**
 Well No. **1** Farm **Hopwaning**
 Elev. _____ Location **SW SW NW**

330 Ft. From **S** Line **NW**
330 Ft. From **W** Line **Quarter**
 Ist. Report **JUL 11 1951**
 Completion _____
 Remarks **B & R Drlg. - Contr.**
 Spudding Date _____
 Drlg. Data **Wildcat**

Drlg. Data **Drlg. 1695**

J. E. TYRA

County **Morris** State **Kansas**
 Sec. **29** (Blk. Twp.) **15** (Sur. Rge.) **5E** Map No.
 Operator **B & R Drlg. & Sohio**
 Well No. **1** Farm **Hopwaning**
 Elev. **1378** Location **SW SW NW**

330Ft. From **S** Line **NW**
330Ft. From **W** Line **Quarter**
 Ist. Report _____
 Completion **JUL 18 1951**
 Remarks **Wildcat**
B & R Drlg. - Contr.
 Spudding Date **7-6-51**

Drlg. Data **D & A TD 2331**
8" @ 130 **Lans. 1670** **Miss. 2197**
DST 2199-2210 **open 1 hr.** **Rec. 30' mud**
TD 2331 **D & A**

J. E. TYRA

Morris ~~KANSAS~~ **KANSAS**
15 R. **5E**

Sec. 29 Twp. 15 R. 5E

Well No. #1 Hopwaning Farm

B & R Drlg. & Sohio Company

B & R Drlg. - Contr. Contractor

Wildcat


Ft. from N. Line

330' Ft. from S. Line

Ft. from E. Line

330' Ft. from W. Line

SW SW NW

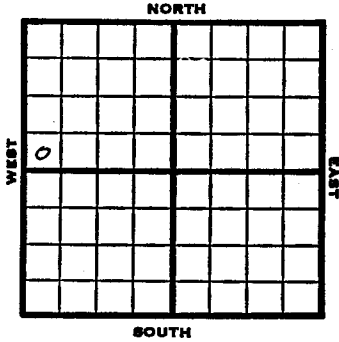


Morris
KANSAS

Section 29 Township 15 Range 5 E

Well No. # 1 Hopwaning

Company B & R Drlg. & Sohio

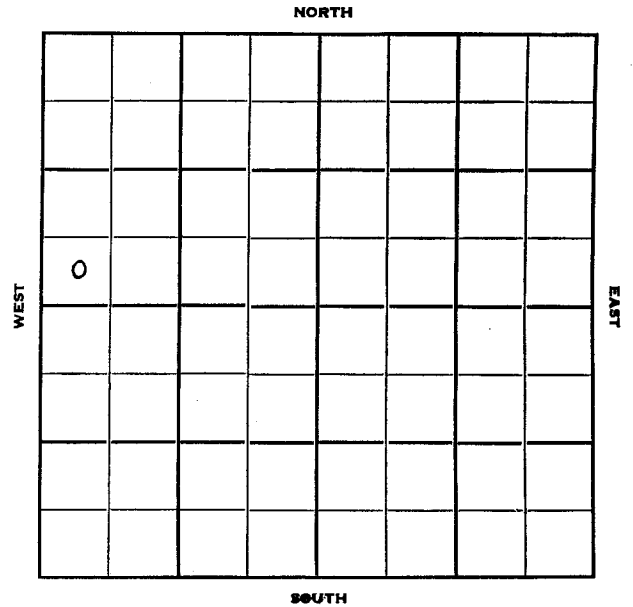

1951 Elev. 1378' REPORT

7/11 Drlg. 1595'
7/18 Spud 7-6-51
D & A TD 2331' 8" @ 130'
Lans. 1670' Miss 2197'
DST 2199-2210' open 1 hr. rec 30' mud
TD 2331' D & A

ABANDONED

2197
1378
- 819