


12-15-5E

WELL LOG BUREAU—KANSAS GEOLOGICAL SOCIETY
508 East Murdock, Wichita, Kansas

Company- E.H. ADAIR OIL CO.
Farm- Johnson No. 1

SEC. 12 T. 15 R. 5E
NE SW SW

County Morris
KANSAS

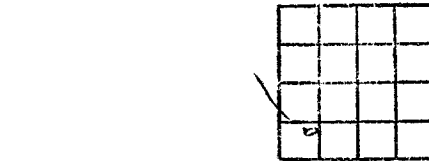

Elevation. 1412' K.B.

Production. DRY

Total Depth. 2434'
Comm. 12-12-59 Comp. 12-18-59
Shot or Treated.
Contractor. Peel Brothers, Inc.
Issued. 1-23-60

CASING:
8 5/8" 137' w/125 sx cem.

Figures indicate Bottom of Formations.

shale, lime	1620
lime	1714
shale	1739
lime	1965
shale	1980
shale, sand	1993
lime	2046
shale, lime	2091
shale	2135
colored chert, shale	2144
chert	2177
sdylomite	2183
lime, shale	2187
lime	2204
dolomite	2214
shale, lime	2224
sdylime	2245
shale	2383
dolomite	2434
Total Depth	

TOPS:

Lansing	1620
B/Kansas City	1965
Conglomerate	2135
Mississippi chert	2144
Mississippi lime	2187
Mississippi dolomite	2204
Kinderhook	2245
Hunton	2383

DST #1, 2143-75: Open 20 mins.
No blow. Rec. 65' of mud.
IBHP=820# in 20 mins. FBHP-720#
in 20 mins.