

Map No. Sec. Twp. R.

Well No. Farm


..... Company

..... Ft. from N. Line

..... Ft. from S. Line

..... Ft. from E. Line

..... Ft. from W. Line

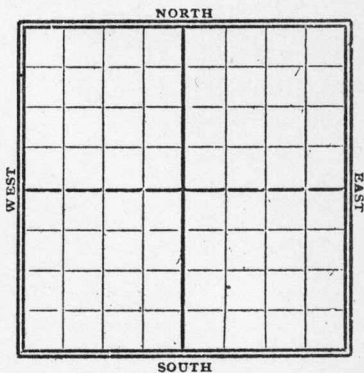

1921

Date

REPORT

Gypsy Records

7/8

HFW 2440'

Abd TD 2453'

43

MAP No. _____ SEC. 6 TWP. 153 R. 7 E

WELL No. 1 B 3rd flush

A.P. Campbell et al COMPANY

we have no Record CONTRACTOR

Scout has never Reported

SECTION PLAT

0			

_____ FT. FROM N. LINE

_____ FT. FROM S. LINE

_____ FT. FROM E. LINE

_____ FT. FROM W. LINE

RECORD

LOCATION _____

CASED _____ IN., _____ FT.

RIG UP _____

SAND _____

DRILLING AND REMARKS:

GAS _____

OIL _____

TOTAL DEPTH 2437

H. Z. Mat
2440'
no Record
in Files
Same

PRODUCTION

1ST 24 HRS. NAT. _____

1ST 24 HRS. AFTER SHOT _____

GAS _____ CU. FT.

DRY HOLE

ABANDONED _____

DATE

7/8

1921

SCOUT