

Morris

KANSAS

Sec. 18 Twp. 15 R. 8 E

Well No. # 1 Lindgren Farm

Carter Oil Company

Contractor

Wildcat


330 Ft. from N. Line

Ft. from S. Line

Ft. from E. Line

330 Ft. from W. Line

NW NW NE

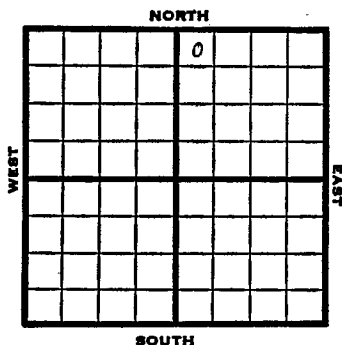


KANSAS

Section 18 Township 15 Range 8E

Well No. #1 Lindgren

Company Carter Oil

NORTH

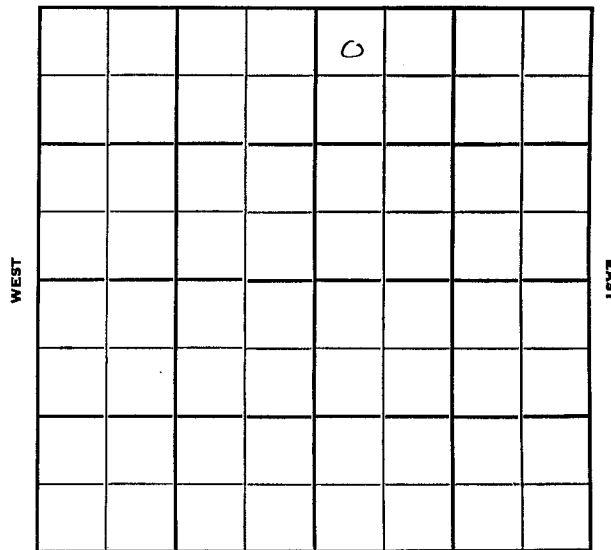

SOUTH

1951 Elev. 1430' REPORT

10/10 Location

11/14 Spud 10-23-51

D & A TD 2912' 8" @ 175'
 Howard 945' Top. 1020' Heeb 3123'
 Lans. 1560' KC 1668' B KC 1904'
 Hunton 2471' Viola 2686'
 DST 2680-90 open 1 hr. rec 2100' sul.
 water Decora 2756' St. Peter 2776'
 Arb. 2867'
 TD 2912' D & A

ABANDONED