

County	Morris	State	Kansas
Sec.	23 (Blk. Twp.)	15 (Sur. Rge.)	9E Map No.
Operator	Carter Oil		
Well No.	1	Farm	Charles Kieffer
Elev.	Location SE SE SW		
	330 Ft. From S Line SW		
	330 Ft. From E Line Quarter		
1st. Report	JAN 27 1954		
Completion			
Remarks	Adkins Drlg. - Contr.		
Spudding Date			
Drlg. Data	John Creek Pool		

Location

J. G. McGEHEE

County	Morris	State	Kansas
Sec.	23 (Blk. Twp.)	15 (Sur. Rge.)	9E Map No.
Operator	Carter Oil		
Well No.	1	Farm	Charles Kieffer
Elev.	1410 RB	Location SE SE SW	
	330 Ft. From S Line SW		
	330 Ft. From E Line Quarter		
1st. Report			
Completion	MAY 19 1954		
Remarks	John Creek Pool		
	Adkins Drlg. - Contr.		
Spudding Date	1-29-54		
Drlg. Data	Oil well TD 3151		

10" @ 147 Top. 971 Heeb. 1299

Lans. 1570 KC 1705 B KC 1925

Miss. 2504 Kh. 2780 Hunton 2929

Viola 3102 DST 3102-27 open 2 hr.

Rec. 2180' oil 1095# DST 3131-51

open 1½ hr. Rec. 90' oil 60' hoem

60' ocw 1060# TD 3151 7" @ 3150

CO to 3129 6/ 3117-18 FU 375' oil

3 hr. 84/ 3103-17 FU 2200' oil 5 hr.

S/ 40 bo 5 bw S/ 47 bo 15 bw 5 hr.

CO to 3134 FU 766' oil 3½ hr.

S/ 73 bo 7 bw 7 hr.

Comp. for shut in well No market

J. G. McGEHEE

Morris KANSAS

SEC. 23	TWP. 15	R. 9 E	✓
---------	---------	--------	---

WELL NO. # 1 Charles Kieffer FARM

COMPANY Carter Oil

CONTRACTOR Adkins Drlg.

John Creek Pool

Ft. from N. Line

330 Ft. from S. Line

330 Ft. from E. Line

Ft. from W. Line

SE SE SW


Morris KANSAS ✓

FORM 51 15-127-00094

Section 23 Township 15 Range 9E

Well No. #1 Charles Kieffer

Company Carter Oil

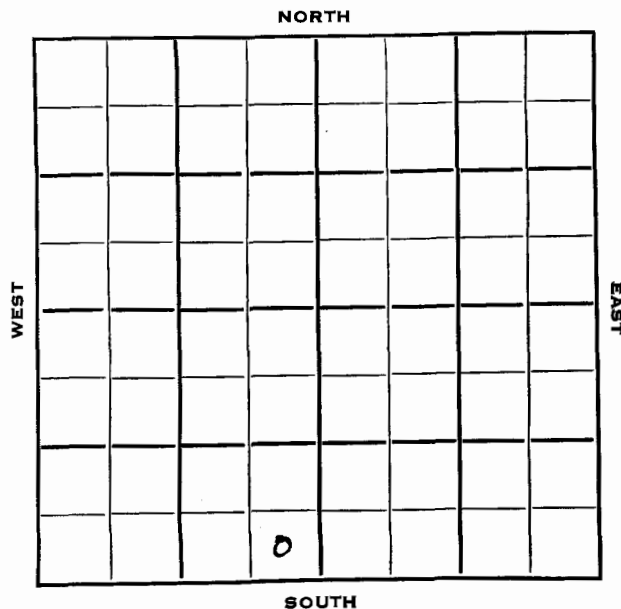

	ELEVATION	REPORT
1954	1410' RB	
1/27	Location	
5/19	Spud 1-29-54 Oil well TD 3151 10" @ 147 Top. 971 Heeb 1299 Lans. 1570 KC 1705 B KC 1925 Miss. 2504 Kh. 2780 Hunton 2929 Viola 3102 DST 3102-27 open 2 hr rec 2180' oil 1095# DST 3131-51 open 1½ hr rec 90' oil 60' HOCM 60' OCW 1060# TD 3151 7" @ 3150 CO to 3129 6/3117-18 FU 375' oil 3 hr. 8/3103-17 FU 2200' oil 5 hr. S/40 BO 5 BW S/47 BO 15 BW 5 hr. CO to 3134 FU 766' oil 3½ hr. S/73 BO 7 BW 7 hr. Comp. for shut in well. No market	
	COMPLETED	