

County **Morris** Elev. **1396 GF**
 Sec. **26** Twp. **15** Rgs. **9E**
 Company **Wm. Gruenerwald et al.**
 Farm Name **Olsen** No. **2**

TOPS	DEPTH	LOG	DATUM	Loc. in Sec.
Anh.				NW SW SW
Top.				
H.				
Tr.				
Dg.				
BL.				
L.				Geol.
K.C.				Contr.
B.K.C.				White & Ellis
Ce.				
C.				
M.				Pool
M.				John Creek
K.				
Mz.				
Mo.				
V.				
S.				
S.				
A.				
R.				
Pe.				
G.				
FD.				

Date Comm. **3-2-56**

MAR 14 1956

8" @ 142/160

County **Morris** Elev. **1396 GF**
 Sec. **26** Twp. **15** Rgs. **9E**
 Company **Wm. Gruenerwald et al.**
 Farm Name **Olsen** No. **2**

TOPS	DEPTH	LOG	DATUM	Loc. in Sec.
Anh.				NW SW SW
Top.				
H.				
Tr.				
Dg.				
BL.				
L.	1550		149	Geol.
K.C.	1710		309	Contr.
B.K.C.	2275		874	White & Ellis
Ce.				
C.				
M.	2517		1116	Pool
M.				John Creek
K.	2747		1346	
Mz. Hunter	2731		1530	
Mo.				
V.	3091		1690	
S.				
S.				
A.				
R.				
Pe.				
G.				
FD.	3096			

Date Comm. **3-2-56**

MAY 23 1956

8" @ 142/160 5 1/2" @ 3092 CO to 3095

FU 300' oil 3 hr. DD 3097

Comp. 25 bopd

Morris

KANSAS

SEC.	TWP.	R.
26	15	9E
WELL NO.		

#2 Olsen

FARM

COMPANY

Wm. Gruenerwald et al

CONTRACTOR

White & Ellis

John Creek


Ft. from N. Line

Ft. from S. Line

Ft. from E. Line

Ft. from W. Line

NW SW SW

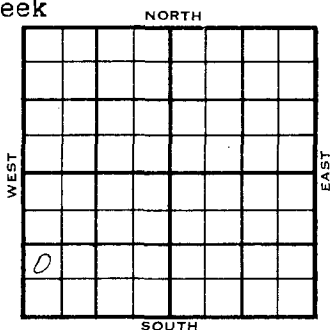

1956

ELEVATION

1401 KB, 1396 RPT

3-14

Comm. 3-2-56

8" @ 142/160

5-23

5 1/2" @ 3092

CO to 3095

FU 300' oil, 3 hrs.,

DD 3097

Comp. 25 bopd

L. 1550', KC. 1710', BKC 2275',

M. 2517', H. 2747', Hunton 2931', X

V. 3091',

TD 3096'

COMPLETED

DX-78

Morris

KANSAS

DX 78-1

Section 26 Township 15 Range 9 E

Well No. #2 Olsen

Company Wm. Gruenerwald et al

