

No County

County Morris Elev. _____
 Sec. 26 Twp. 15 Rge. 9E
 Company Carter Oil
 FarmName W. O. Olsen No. 1

County Morris Elev. 1403
 Sec. 26 Twp. 15 Rge. 9E
 Company Carter Oil
 FarmName W. O. Olsen No. 1

TOPS	DEPTH	LOG	DATUM	Loc. in Sec.
Anh.				NW NE SW
TP.				
H.				
Tr.				
Dg.				
Bl.				
L.				Geol.
K.C.				Contr.
B.K.C.				<u>Adkins</u>
Ce.				Pool
C.				<u>John Creek</u>
M.				
M.				
K.				
Mz.				
Me.				
V.				
S.				
S.				
A.				
R.				
PE.				
G.				
TD.				

TOPS	DEPTH	LOG	DATUM	Loc. in Sec.
Anh.				NW NE SW
TP.				
H.				
Tr.				
Dg.				
Bl.				
L.	<u>1578</u>		<u>175</u>	Geol.
K.C.	<u>1707</u>		<u>304</u>	Contr.
B.K.C.	<u>1926</u>		<u>323</u>	<u>Adkins</u>
Ce.				Pool
C.				<u>John Creek</u>
M.	<u>2495</u>		<u>1092</u>	
M.				
K.	<u>2768</u>		<u>1361</u>	
Mz.	<u>Hunt 2906</u>		<u>1523</u>	
Me.	<u>3028</u>		<u>1605</u>	
V.	<u>3077</u>		<u>1674</u>	
S.				
S.				
A.				
R.				
PE.				
G.				
TD.	<u>3079</u>			

FIRST REPORT
 JUN 22 55

COMPLETE

Date Comm. Cellar & pits

Date Comm. 6/23/55 DST 2906-11 open 1 hr

5 1/2" 3078 w/150 FU 200' oil no wtr. 1 1/2 hr
Swb 30 bo no wtr 4 hrs. gr. 27.4°
POP Ph P. 80 bopd no wtr

Rec. 850' wtr GP 28-368 BHP 1100# 20"
5 1/2" 3078 w/150 FU 200' oil no wtr. 1 1/2 hr
Swb 30 bo no wtr 4 hrs. gr. 27.4°
POP Ph P. 80 bopd no wtr

Morris KANSAS

SEC. 26 TWP. 15 R. 9E

WELL NO. I W. O. Olsen FARM

COMPANY Carter Oil

CONTRACTOR Adkins


John Creek

Ft. from N. Line

Ft. from S. Line

Ft. from E. Line

Ft. from W. Line

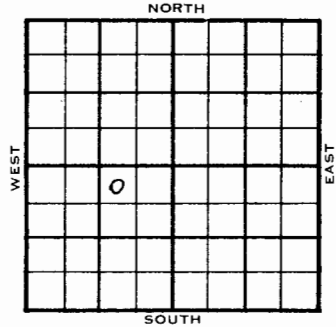

NW NE SW

	ELEVATION	REPORT
1965	1403'	

6/22 C & P

9-21 Comm. 623-55
 DST 2906-11 op 1 hr. rec 850' wtr
 GP 28-368 BHP 1100# 20"
 5 1/2" @ 3078 w/150 FU 200' oil no wtr.
 1 1/2 hr.
 Swb 30 bo no wtr 4 hrs. gr. 27.4°
 POP Ph P. 30 bopd no wt.r
 Topd: L. 1578
 KC 1707
 BKC 1926
 M. 2495
 K. 2764
 Hunt 2906
 Mq. 3008
 V. 3077
 TD 3079'

COMPLETED

DX 78-1 Morris KANSAS

Section 26 Township 15 Range 9E

Well No. #1 W. O. Olsen

Company Carter Oil

