

County <u>Morris</u>		Elev. <u>1371 DF</u>		C.O.
Sec. <u>26</u> Twp. <u>15</u> Rge. <u>9E</u>		Elev. <u>1376 KB</u>		
Company <u>Grunerwald</u>				L.S.
Farm Name <u>Williams</u> No. <u>3</u>				
TOPS	DEPTH	LOG	DATUM	Loc. in Sec.
Anh.				NW SE SW
TP.				
H.				
Tr.				
Dg.				
BL.				
L.	<u>1538</u>		<u>167</u>	Geol.
K.C.	<u>11679</u>		<u>308</u>	Contr.
B.K.C.	<u>1895</u>		<u>524</u>	
Ce.				<u>K & E Drlg.</u>
C.	<u>2488</u>		<u>1117</u>	Pool
M.				
K.	<u>2741</u>		<u>1370</u>	
Mz. <u>Hunton</u>	<u>2886</u>		<u>1515</u>	
Mo.	<u>2986</u>		<u>1615</u>	
V.	<u>3054</u>		<u>1683</u>	
S.				
S.				
A.				
R.				
Pe.				
G.				
TD.	<u>3063</u>			

ABANDONED

Date Comm. 11-26-54 JUN 15 1955

8" @ 144/75 5 1/2" @ 3054/150 DD 3067

FU 860' oil 11 hr. DD 3070 FU 1200'

oil 15 hr. DD 3072 FU 1340' oil 17 hr

DD 3073 FU 1430' oil 18 1/2 hr.

Shut down - temporary abd. - no market

SCOUT PACKET DX-201

SEC. <u>26</u>	TWP. <u>15</u>	R. <u>9E</u>
----------------	----------------	--------------

WELL NO. 3 Williams FARM

COMPANY Grunerwald

CONTRACTOR CORRECTION

NW SE SW

_____ FT. FROM N. LINE

990 FT. FROM S. LINE

990 FT. FROM E. LINE

_____ FT. FROM W. LINE

NORTH

SOUTH

Morris County X

☐ LOCATION

☐ RIG UP

DRILLING AND REMARKS:

Reported
NW SE NW

RECORD	CASED IN..	FT.
	SAND	
	GAS	
	OIL	
PRODUCTION	TOTAL DEPTH	
	1ST 24 HRS. NAT.	
	1ST 24 HRS. AFTER SHOT	
	GAS	CU. FT.
DRY HOLE		
ABANDONED		

DATE JUN 15 1955 SCOUT

County **Morris** State **Kansas**

Sec. **26** (Bk. **15** (Sur. **9E** Map No.

Operator **William Grunerwald**

Well No. **3** Farm **Williams**

Elev. Location **NW SE SW**

FIRST REPORT

990 Ft. From S Line SW

990 Ft. From E Line Quarter

1st. Report NOV 23 1955

Completion

Remarks

K & E Drlg. - Contr.

Spudding Date

Drig. Data

John Creek Pool

Location

FABEN GILSTRAP

SEC.	TWP.	R.
26	15	9E

WELL NO. #3 Williams FARM

COMPANY William Grunerwald

CONTRACTOR K & E Drlg.

_____ Ft. from N. Line

990 _____ Ft. from S. Line

990 _____ Ft. from E. Line

_____ Ft. from W. Line

NORTH

SOUTH

NW SE SW

1954	ELEVATION	REPORT
11/23	Location	
6/15	8" @ 144/75 5½ @ 3054/150 DD 3067 FU 860' oil 11 hr. DD 3070 FU 1200' oil 15 hr. DD 3072 FU 1340' oil 17 hr. DD 3073 FU 1430' oil 18½ hr. Shut down temp. abd. no market	
	Tops	Depth Datum
	L.	1538 167
	KC	1679 308
	BKC	1895 524
	M	2488 1117
	K	2741 1370
	MZ. Hunt.	2886 1515
	Mq.	2986 1615
	V.	3054 1683
	TD.	3063
ABANDONED		

DX 78-1


Morris

KANSAS

Section 26 Township 15 Range 9E

Well No. #3 Williams

Company William Grunerwald

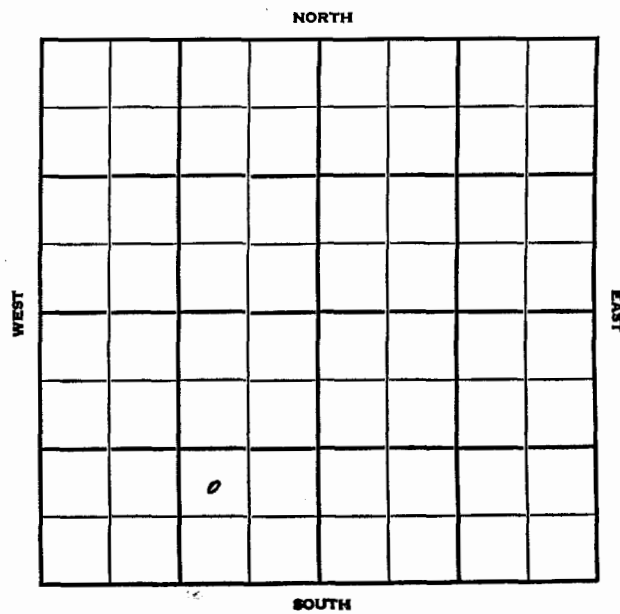

Other docs have NW SE NW