

No County Map

County Morris Elev. _____
 Sec. 35 Twp. 15S Rge. 9E
 Company The Carter Oil Co.
 Farm Name M. Hermstein No. 1

TOPS	DEPTH	LOG	DATUM	Loc. in Sec.
Anh				NW SW NE
Tr.				DS - SE 1/4 & S 1/4 NE 1/4
H.				
Tr.				
Dg.				
Bl.				
L.				Geol.
K.C.				
B.K.C.				Contr.
Cc.				Adkin Drlg.
C.				
M.				Pool
M.				John Creek
K.				
Mz.				
Me.				
V.				
S.				
S.				
A.				
R.				
PC.				
G.				
TD.				

FIRST REPORT
 AUG 8 '56

Date Comm. 8-3-56; 8" 151 w/100 sx; WOC

No County Map

County Morris Elev. 1388 DF
 Sec. 35 Twp. 15S Rge. 9E
 Company The Carter Oil Co.
 Farm Name M. Hermstein No. 1

TOPS	DEPTH	LOG	DATUM	Loc. in Sec.
Anh				NW SW NE
Tr.				DS - SE 1/4 & S 1/4 NE 1/4
H.				
Tr.				
Dg.				
Bl.				
L.				Geol.
K.C.				
B.K.C.				Contr.
Cc.				Adkin Drlg.
C.				
M.				Pool
M.				John Creek
K.				
Mz.				
Me.				
V.				
S.				
S.				
A.				
R.				
PC.				
G.				
TD.				

COMPLETE
 SEP 12 '56

Date Comm. 8-3-56; 8" 151 w/100 sx; WOC AUG 15 '56

3075 AUG 22 '56 5 1/2 @ 3124/150
RUCT SEP 5 '56 CO 3081 24/
3060-64 FU 1280' w/16 1 3/4 hrs
280 SEP 12 '56 59d cu 3081 48/
3066-68 @ 42 Do + 1 BW 6
hrs @ rate 168 Do pd
+ 4 BW pd.

Morris

KANSAS

SEC. 35	TWP. 15	R. 9E
------------	------------	----------

WELL NO. #1 M. Hermstein FARM

COMPANY The Carter Oil Co.

CONTRACTOR Adkin Drlg.


John Creek

FT. FROM N. LINE _____

FT. FROM S. LINE _____

FT. FROM E. LINE _____

FT. FROM W. LINE _____

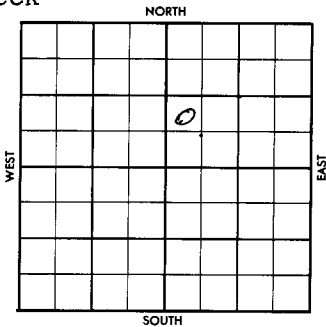

NW SW NE

1956	ELEVATION	REPORT
------	-----------	--------

8-8 Comm. 8-3-56
8" @ 151 w/100 sx;
WOC

COMPLETED

DX 78-1 Morris

KANSAS

Section 35 Township 15S Range 9E

Well No. #1 M. Hermstein

Company The Carter Oil Co

