

No County Map

County Morris Elev.
 Sec. 35 Twp. 15 Rge. 9E
 Company Carter Oil Co.
 FarmName William O. Olsen No. 4

TOPS	DEPTH	LOG	DATUM	Loc. in Sec.
Anh.				NW SE NW
Tr.				
H.				
Tr.				
Dg.				
Bl.				
L.				Geol.
K.C.				Contr.
B.K.C.				Adkins Drlg.
Ce.				Tools.
C.				Pool
M.				John Creek
M.				
K.				
Mz.				
Me.				
V.				
S.				
A.				
R.				
PE.				
G.				
TD				

SEP 12 '56
 FIRST REPORT

Date Comm. 9-5-56
8" @ 147 w/75, Drlg. 1785

(No County Map)

County Morris Elev. 1345 DF
 Sec. 35 Twp. 15 Rge. 9E
 Company Carter Oil Co.
 FarmName William O. Olsen No. 4

TOPS	DEPTH	LOG	DATUM	Loc. in Sec.
Anh.				NW SE NW
Tr.				
H.				
Tr.				
Dg.				
Bl.				
L.				Geol.
K.C.				Contr.
B.K.C.				Adkins Drlg.
Ce.				Tools.
C.				Pool
M.		2450		John Creek
M.		2729		
K.		2876		
Me.	HUNT	2961		
Me.		3032		
V.				
S.				
A.				
R.				
PE.				
G.				
TD				

OCT 31 '56
 COMPLETE

Date Comm. 9-5-56
8" @ 147 w/75, Drlg. 1785 SEP 19 '56

5 1/2 @ 3090/150 SEP 26 '56 co 3054
 60' 3034-44 \$ 17 1/2 BO no/w
 4 hrs. 9 am 25.4
 OCT 3 '56 P. 156 BOPD no/w

Morris

KANSAS


SEC. 35 TWP. 15 R. 9E

WELL NO. #1 William O. Olsen FARM

COMPANY Carter Oil Co.

CONTRACTOR Adkins Drlg Tools John Creek

FT. FROM N. LINE
FT. FROM S. LINE
FT. FROM E. LINE
FT. FROM W. LINE

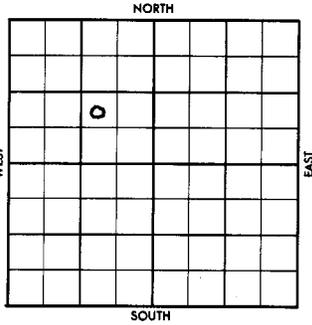

NW SE NW

1956 ELEVATION REPORT

9-12 Comm 9-5-56
8" @ 147 w/75
Drlg 1785

Morris

KANSAS

SECTION 35 TOWNSHIP 15 RANGE 9E

WELL NO. #1 William O. Olsen

COMPANY Carter Oil Co.

