


Section 8 Township 16 Range 1E

Well No. #1 Bozarth

Company Vickers

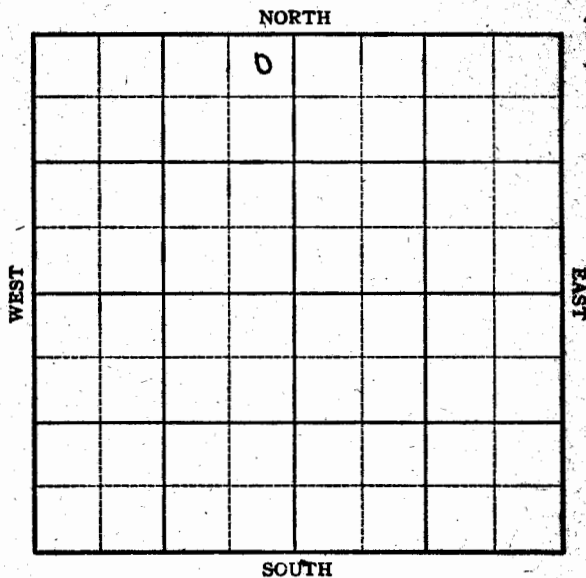

Sec. 3 Twp. 16 R. 1E

Well No. #1, Bozarth Farm

Vickers Company

Wildcat


330 Ft. from N. Line

Ft. from S. Line

330 Ft. from E. Line

Ft. from W. Line

NE NW

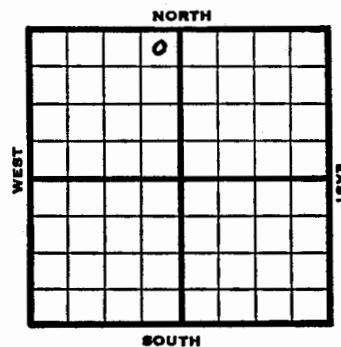

1946 Elev. 1276 REPORT

6/12 Location
6/18 8" @ 115
Drlg 2450'
6/26 Lans 1913
Mis s 2558'
Drlg 2640'
7/3 Misner 2889
Hunton 2904
Fsg 3117
7/9 " "
7/16 " "
7/23 " "
7/30 Viola 3150
Drlg 3155'
8/7 Simp. 3242
Arb. 3305
TD 3350'

2904
2558
346

ABANDONED

2558
1276
-1272

KANSAS Kansas Pool Name WildcatMap No. 20 Sec. 3 Twp. 16 R. 1EWell No. 1 Bozarth

Vickers Company

FIRST REPORT

NE NW


SECTION PLAT

330 Ft. from N. Line

Ft. from S. Line

330 Ft. from E. Line

Ft. from W. Line

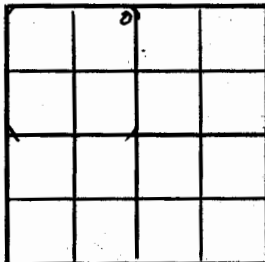

Dickinson County

Location X

Rig up

Drilling and Remarks:

RECORD

Cased in, ft.

Sand

Gas

Oil

Total Depth

PRODUCTION

1st 24 hrs. Nat.

1st 24 hrs. after shot

Gas Cu. Ft.

Dry Hole

Abandoned

Date

JUN 12 1946

19

S. J. LEWIS

Scout

KANSAS Kansas Pool Name WildcatMap No. 25 Sec. 3 Twp. 16 R. 1EWell No. 1 Bozarth

Vickers Company

ABANDONED

Contractor

NE NW


SECTION PLAT

330 Ft. from N. Line

Ft. from S. Line

330 Ft. from E. Line

Ft. from W. Line

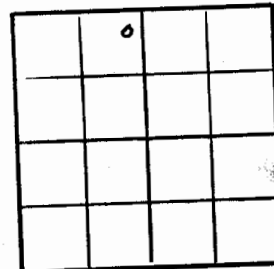

Dickinson County

Location

Rig up

Drilling and Remarks:

Shut 3242
at 9905

RECORD

Cased in, ft.

Sand

Gas

Oil

Total Depth 9950

PRODUCTION

1st 24 hrs. Nat.

1st 24 hrs. after shot

Gas Cu. Ft.

Dry Hole

Abandoned

Date

AUG 7 1946

19

S. J. LEWIS

Scout