


KANSAS

Section 20 Township 16 Range 1E  
 Well No. #1 J. B. Dougan  
 Company Continental Oil

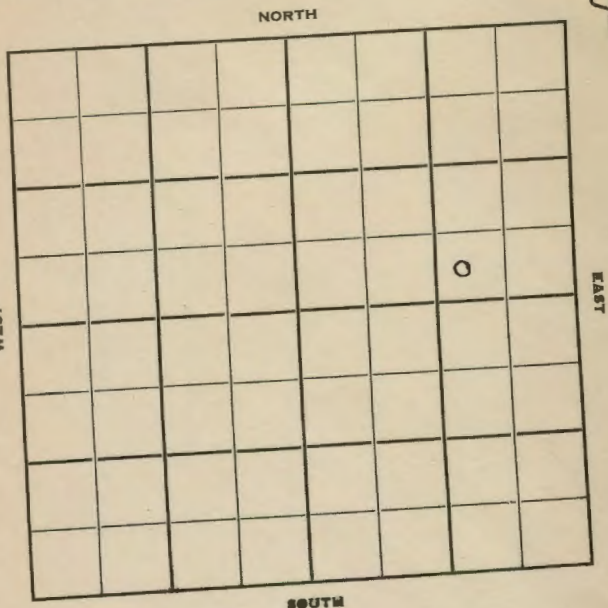


Dickinson

KANSAS

Sec. 20 Twp. 16 R. 1E ✓  
 Well No. #1 J. B. Dougan Farm  
Continental Oil Company  
 Contractor

Wildcat  
 Ft. from N. Line  
330 Ft. from S. Line  
990 Ft. from E. Line  
 Ft. from W. Line

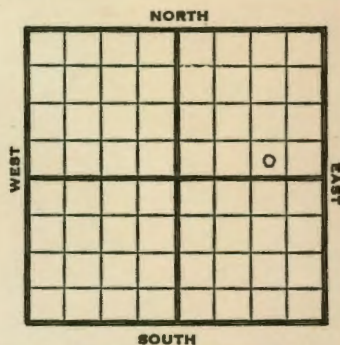

SW SE NE

1951

Elev. 1418' REPORT

8/8

R U R

8/29

D&A TD 3483  
 13 1/4" @ 210  
 DST 3025-30 opn 1 hr  
 Rec. 2' mud DST 3030-40 opn 1 hr.  
 Rec. 42' mud 120' sw  
 Hunton 3043 Maq. 3165  
 Viola 3268 Simp. 3361  
 DST 3269-74 opn 1 hr  
 Rec. 10' mud  
 DST 3274-84 opn 1 hr Rec. 15' mud  
 Cored 3364-74 rec 10'  
 Cored 3374-92 rec 6 1/2'  
 DST 3380-91 opn 1 hr  
 Rec. 70' wtr Arb. 3420  
 TD 3483  
 D&A

**ABANDONED**

County **Dickinson** State **Kansas**  
 Sec. **20** (Blk. Twp.) **16** (Sur. Rge.) **1E** Map No.  
 Operator **Continental Oil**  
 Well No. **1** Farm **J. B. Dougan**  
 Elev. Location **SW SE NE**

FIRST REPORT									

**330** Ft. From **S** Line **NE**  
**990** Ft. From **E** Line Quarter  
 1st. Report **AUG 8 1951**  
 Completion  
 Remarks  
 Spudding Date

Drig. Data **Wildcat**  
**RUR**

J. E. TYRA

County **Dickinson** State **Kansas**  
 Sec. **20** (Blk. Twp.) **16** (Sur. Rge.) **1E** Map No.  
 Operator **Continental Oil**  
 Well No. **1** Farm **J. B. Dougan**  
 Elev. **1418** Location **SW SE NE**

ABANDONED									

**330** Ft. From **S** Line **NE**  
**990** Ft. From **E** Line Quarter  
 1st. Report  
 Completion **AUG 29 1951**  
 Remarks **Wildcat**  
 Spudding Date

Drig. Data **D & A** **TD 3483**  
**13 1/4"** @ 210 DST 3025-30 open 1 hr.  
 Rec. 2' mud DST 3030-40 open 1 hr.  
 Rec. 42' mud 120' sw Hunton 3043  
 Mag. 3165 Viola 3268 Simp. 3361  
 DST 3269-74 open 1 hr. Rec. 10' mud  
 DST 3274-84 open 1 hr. Rec. 15' mud  
 Cored 3364-74 rec. 10' Cored 3374-92  
 rec. 6 1/2' DST 3380-91 open 1 hr.  
 Rec. 70' water Arb. 3420 TD 3483  
**D & A**

J. E. TYRA