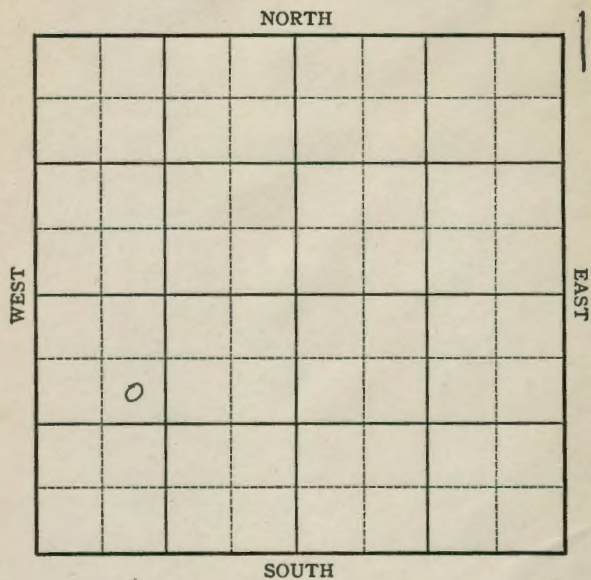


KANSAS

FORM 51 5M 1-42 PETROL


Dickinson

Section 31 Township 16 Range 1-EWell No. #1 EgglestonCompany Adair & Morton & Phil-HanForm 252-A
5M 5-42 Petrol**KANSAS**

Dickenson

Sec. 31 Twp. 16 R. 1-EWell No. #1 Eggleston FarmAdair & Morton & Phil-Han Company

Wildcat

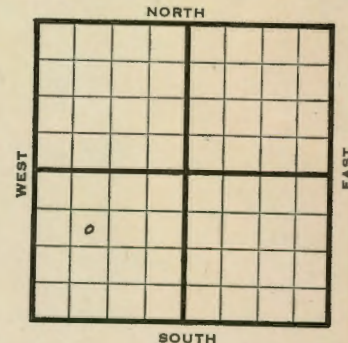990 Ft. from N. Line Ft. from S. Line Ft. from E. Line990 Ft. from W. Line

1943

REPORT

3/31

8" @ 160'

4/7

Miss. 2706'

T.D. 2719'

ABANDONED

Dickinson

Map No. **KANSAS** Sec. 31 Twp. 16 R. 1E

Well No. 1 Eggleston

Adair & Morton & Company

FIRST REPORT Phil-Han Contractor

SE NW SW


SECTION PLAT

990 Ft. from N. Line

Ft. from S. Line

Ft. from E. Line

990 Ft. from W. Line

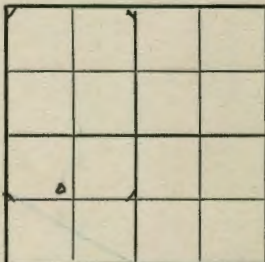

WILDCAT

Location

Rig up

Drilling and Remarks:

8"-160'

RECORD

Cased in, ft.

Sand

Gas

Oil

Total Depth

PRODUCTION

1st 24 hrs. Nat.

1st 24 hrs. after shot

Gas Cu. Ft.

Dry Hole

Abandoned

Date

MAR 31 1943

19

S. J. LEWIS Scout

Dickinson

Map No. **KANSAS** Sec. 31 Twp. 16 R. 1E

Well No. 1 Eggleston

Adair & Morton & Phil-Han Company

ABANDONED Contractor

SE NW SW


SECTION PLAT

990 Ft. from N. Line

Ft. from S. Line

Ft. from E. Line

990 Ft. from W. Line

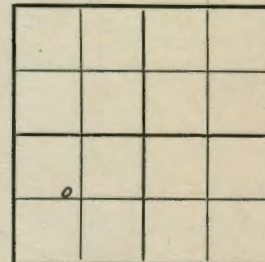

WILD CAT

Location

Rig up

Drilling and Remarks:

Miss 2706

RECORD

Cased in, ft.

Sand

Gas

Oil

Total Depth 2719

PRODUCTION

1st 24 hrs. Nat.

1st 24 hrs. after shot

Gas Cu. Ft.

Dry Hole

Abandoned

Date

APR 7 1943

19

S. J. LEWIS Scout